

DOCUMENT DATA FORM

Your Name: Nick Carino

Document Title or Description (max. 254 characters): Circle: Same as cover (or fill in below)

Correspondence, updated ~~from~~ floor truss designs.

Include work order no. and floor no. if applicable

Roll #: RD-4

Doc. ID (report #, dwg. #):

Document Date:

1967

Document Author Name:

Author Organization:

Laclede Steel Co.

KEYWORDS - HIGHLIGHT ALL THAT APPLY

Level: 1

Bankers Trust

Project 6

WTC 4 - South Plaza Bldg.

Concourse

Project 7

WTC 5 - North Plaza Bldg.

Electrical Substation

Project 8

WTC 6 - Customs House

Liberty Plaza

WFC 1 - Oppenheimer Dow

WTC 7

PATH Station

WFC 2 - Tower B

WTC Complex

Project 1

WFC 3 - American Express

WTC Plaza

Project 2

WFC 4 - Tower D

Add

Project 3

WTC 1 - North Tower

Project 4

WTC 2 - South Tower

Project 5

WTC 3 - Marriot Hotel

Accident analysis & risk

Fire protection

Police

Add

Architectural

Fire service

Security

Data request

Management

Structural

Emergency management

Mech./elec.

Tenant alterations

Evacuation

News coverage

Level:

1993 explosion

Deflection

Human comfort

Smoke control

A/E fitout

Demolition

HVAC

Smoke test

A-242

Design

Index

Spandrel beam

A-36

Detailing

Inspection

Specifications Splices

A-497

Doors

Insulation

Sprinkler

Air cooled condensers

Drawings

Job number

Stability

Analysis

Eastern States Steel

Joist

Stairways

Angles

Egress

L-50

Standards

Antenna

Elevator

Lighting

Steel

Artifacts

Emergency communications

Loads

Steel composition

Asbestos

Equipment

Maintenance

Stiffness

Beams

Erection marks

Marking

Structural review

Bow tie

Escalator

Mesh reinforcement

Survivor

Bracing

Expansion joint

Mill inspection

Tenant list

Bridging truss

Exterior columns

Model

Testing

Calculations

Fabrication

Mullion

Tie

Carpet

Family member

Operations

Tolerances

Ceilings

Field survey

Paint

Triad

Certification

Fire alarms

Partition layout

Truss

Chillers

Fireproofing

Photos

Vestibule

Cladding

Fire spread

Pipes

Vibration

Collapse

Flammability

Plumbing

Walls

Columns

Floor

Probability, uncertainty

Water supply

Communication systems

Floor load

Quality control

Weather

Composite truss

Floor slab

Reinforcing (strengthening)

Weight

Computer output

Floor system

Renovation

Weld detail

Computer program

Floor trusses

Repair

Weld size

Concrete

Foundations

Research & Development

Welding

Connections

Fracture

Roof

Wind

Construction

Frame

Safety

Windows

Contract

Frame analysis

Schedule

Yield strength

Core beams

Frequency

Sculpture

Core columns

Fuel

Security system

Add

Cranes

Furniture layout

Shear knuckle

Criteria

H Generators

Shear test

Dampers

Guidelines

Shop drawings

Debris

Gypsum board

Shortening

Deck

Hat truss

Slurry wall

WTCL-733-LERA

LACLEDE '67

ACLEDE STEEL COMPANY

Mr. Joe Solomon
Emery Roth & Sons

Page 2

February 24, 1967

Under separate cover you are receiving ⁷ ~~six~~ copies ~~and six~~
~~copies~~ for each of the "ST" details listed as follows

Revised detail ST-107 replaced detail submitted 2/10/67
Revised sheet L-101 replaced L-101 submitted 2/10/67

The revisions on these two sheets are minor marks of identification and in no way affect the geometric configuration of the structural members used to guide the designers of mechanical and electrical facilities.

The remainder of the ~~ST~~ details forthcoming under separate cover are:

ST-105	ST-106i
ST-106	ST-106f
ST-106A	ST-109
ST-106b	ST-110
ST-106C	

Detail L-100 is also included to complete the list of details necessary to cover the range of truss members incorporated in the floor grids.

We would appreciate your acknowledgement of receipt of these details so that we may keep our records up to date.

Yours very truly,

A. Carl Weber
Vice President
Resident Engineer

AC:pp

Enclosures

cc Mr. Eagle River
Port Authority, Building
Mr. Jackson

Mr. Nicolaiev
Port of New York Authority

Mr. Lester Ellis
Port of New York Authority

Laclede Steel Company

General Office - Inside Building

W. Lewis - Museum 63101 February 24, 1961

Mr. Joe Solomon
Project Manager
Emery Roth & Sons
850 Third Avenue
New York, New York 10022

Dear Mr. Solomon:

Laclede Steel Company Structural Details World Trade Center Towers

Enclosed herewith is a loose-leaf folder including the following material relative to all structural details required for the trusses and incidental structural items for the floor grids on the World Trade Center:

Index sheets covering structural details ("ST" drawings and "L" drawings).

Design sheets covering configuration and sizing of truss members.

Detail sheets.

D101 replaces D1 (submitted previously)

D102 replaces D2

D103 replaces D3 (submitted previously)

D105-T-1 showing design data for truss marked 203211

D105-T-5 showing design data for truss marked 203215

As explained in the design data material, all trusses are evaluated on the basis of the most critical sections identified by numbers 1 through 8 inclusive on the design details and standards.

The remainder of the complete data sheets for all trusses as marked in the index will be forthcoming shortly to complete all structural data on hand. The T-1 and T-5 trusses are the basic trusses in the design, and the check and approval of them will establish the values applicable on all other structural elements identified.

WORLD TRADE CENTER
FLOOR GRID TRUSSES
DESIGN DATA

TRUSS UNIT MARKED 2C3ZT5 Refer to drawings ST 101, 6, 8.

Clearspan "L" = 54.83 ft. Spacing = 6.67 ft.

Applicable Total Moment = 1,920,000 inch pounds.

Based on 154 lbs./sq. ft. Total Load "W". [31' PARTIAL
LOADING]

Applicable End Reaction = 18,000 pounds.

Based on 154 lbs./sq. ft. Total Load "W".

Applicable Total Constr. Moment = 585,000 inch pounds.

Based on 46 lbs./sq. ft. Construction Load.

Applicable Constr. End Reaction = 5470 pounds.

Based on 46 lbs./sq. ft. Construction Load.

"V" Shear at End Panel = 14,920 pounds. ED = 3.0 ft.

WEB MEMBER #1 Distance from End Panel = 0.0 ft.

Applicable Shear V_x = 14,920 lbs. f_y = 50,000 psi

Slope = 265 f_s = 30,000 psi

l = in. f_{sc} = psi

Reqd. Area = 1.34 sq. in. Use 2-3/4" x 1/4"

WEB MEMBER #2 Distance from End Panel = 0.0 ft.

Applicable Shear V_x = 14,920 lbs. f_y = 36,000 psi

Slope = 100 f_s = psi

l = 26.0 in. f_{sc} = 11,200 psi

Reqd. Area = 1.33 sq. in. Use 2-0.92" dia Area = 1.33 sq. in.

WEB MEMBER #3 Distance from End Panel = 4.87 ft.

Applicable Shear V_x = 9,920 lbs. f_y = 36,000 psi

Slope = 1162 f_s = psi

l = 30.0 in. f_{sc} = 8,750 psi

Reqd. Area = 1.32 sq. in. Use 2-0.92" dia Area = 1.33 sq. in.

WEB MEMBER #4 Distance from End Panel = 3.21 ft. (GD = 2.00')
 Applicable Shear $V_x = \underline{12,570}$ lbs. $f_y = \underline{50,000}$ psi
 Slope = 1.162 $f_s = \underline{\quad}$ psi
 $l = \underline{30.0}$ in. $f_{sc} = \underline{9,970}$ psi
 Req'd. Area = 1.47 sq. in. Use 2-0.98" DIA Area = 1.51 sq. in.

WEB MEMBER #5 Distance from End Panel = 0.0 ft. (GD = 2.00')
 Applicable Shear $V_x = \underline{15,845}$ lbs. $f_y = \underline{50,000}$ psi
 Slope = 1.90 $f_s = \underline{30,000}$ psi
 $l = \underline{\quad}$ in. $f_{sc} = \underline{\quad}$ psi
 Req'd. Area = 1.01 sq. in. Use 2-0.92" DIA Area = 1.33 sq. in.

CHORD MEMBER #6 Consists of 4-2" x 1 1/2" x 0.25" Angles
 Construction Load Design Area = 3.60 sq. in.
 Applicable Moment = 585,000 in. lbs. $f_y = \underline{50,000}$ psi
 $l = \underline{33.375}$ in. $f_s = \underline{\quad}$ psi
 $r_x = \underline{0.44}$ in. $f_{sc} = \underline{12,930}$ psi
 $r_z = \underline{0.31}$ in. (with fillers in middle 60% of span)
 $\frac{l}{r_x} = \underline{75.8}$
 $\frac{l}{2r_z} = \underline{107.5}$

$$\frac{f_a}{F_a} + \frac{f_b C_m}{F_b (1 - \frac{f_a}{F'_e})} = \underline{0.477}$$
 less than 1
 $f_a = \underline{5,800}$ psi
 $F_a = \underline{12,930}$ psi
 $f_b = \underline{748}$ psi
 $F_b = \underline{30,000}$ psi
 $F'_e = \underline{25,950}$ psi
 Use 4-2" x 1 1/2" x 0.25" X's Area = 3.60 sq. in.

CHORD MEMBER #7 Consists of 4-2" x 1 1/2" x 0.25" Angles
 Total Load Design Area = 3.60 sq. in.

CHORD MEMBER #7 (CONTD.)

Applicable Moment = 1,920,000 in lbs. $f_y = \underline{36,000}$ psi $D_t = \underline{33.00}$ in. $f_s = \underline{22,000}$ psi $a_{eff} = \underline{64.00}$ in. $f_{sc} = \underline{\quad\quad}$ psi $t = \underline{4.00}$ in. $y_1 = \underline{2.00}$ in. $d_2 = \underline{2.44}$ in. $y_2 = \underline{4.44}$ in. $d_3 = \underline{25.66}$ in. $y_3 = \underline{32.56}$ in. $c_1 = \underline{6.90}$ in. $d_1 = \underline{4.90}$ in. $c_2 = \underline{26.10}$ in.

$$I_s = \sum [(I_c + A_c d_1^2) + (I_{TCA} + A_{TCA} d_2^2) + I_{BCA} + A_{BCA} d_3^2]$$

$$\bar{y} = \frac{\sum (A_c y_1 + A_{TCA} y_2 + A_{BCA} y_3)}{\sum (A_c + A_{TCA} + A_{BCA})}$$

 $\bar{y} = \underline{6.90}$ in. $I_s = \underline{2826}$ in.⁴ (2C3ZT5)Resisting Moment = $f_s \times \frac{I_s}{c_2} = \underline{2,580,000}$ in. lbs.Use 4 - 2" x 1/2" x 0.25" L's Area = 3.60 sq. in.

Composite Design Top Chord Check

Total Load Design

 $f_c = \underline{3,000}$ psiApplicable Moment = 1,920,000 in. lbs. $f'_c = \underline{1,350}$ psi


$$f'_{cc} = \frac{M_{CS}}{15I_c} = \underline{312}$$
 psi

CHORD MEMBER #8

Consists of 4 - 2" x 1/2" x 0.25" AnglesArea = 3.60 sq. in.

(SAME AS MEMBER 6)

WORLD TRADE CENTER
FLOOR GRID TRUSSES
DESIGN DATA

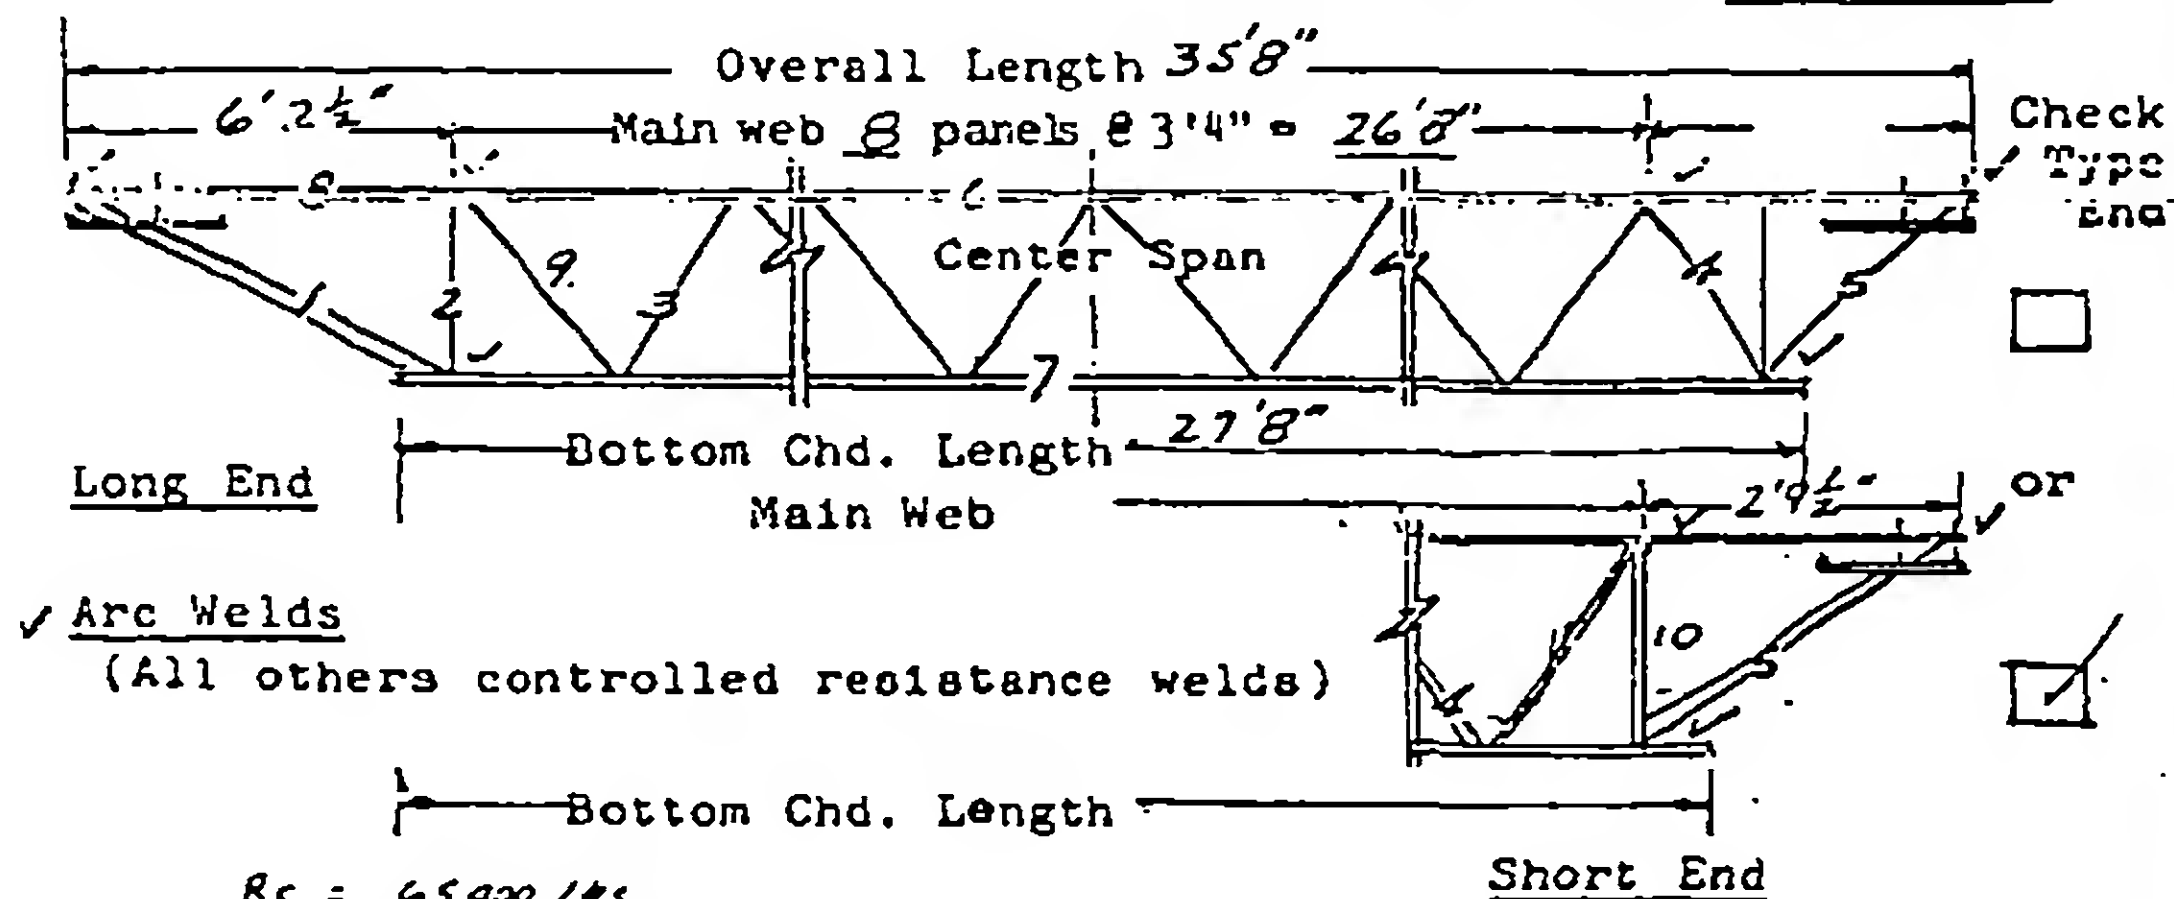Truss Mk. 2 C32T6-358Truss Component Mk. C.32T6

✓ Arc Welds

(All others controlled resistance welds)

$$R_c = 65,000 \text{ lbs.}$$

$$W_c = \frac{R_c}{L} = 3,640 \text{ lbs.}$$

$$R_w = 32,000 \text{ lbs.}$$

$$W_w = \frac{R_w}{L} = 1,790 \text{ lbs.}$$

NOTES:

Main Web - Continuous uniform section throughout Member Mk. 3.
(Top chord fillers same section as Main Web - at midpoint 6
center web panels minimum.)

Vertical Struts Mk. 2 - Same size as main web.

End Bearing Struts - Same size as main web.

Composite type - Webs extend above top chord 5.

MEMBERS REQUIRED PER TRUSS COMPONENT S or C ✓

Member	Mk.No.	Grade of Steel	Size	Total Length Member	Weight Member
Top Chord	6-8	A-441	2 Ls 2" x 1 1/2" x 31"	35'8"	
Bottom Chord	7	A-36	2 Ls 3" x 2" x 37"	27'8"	
Main Web	3	A-441	1.14"D	48'9"	
Compression Web	4	A-441	2 - 1.14"D	3'1"	
Vertical End Struts	2	A-441	1.14"D	2'7 1/2"	
Long End Diagonal	1	A-441	1.14"D + .75"D	66" - 64"	
Short End Diagonal	5	A-441	1.14"D + .75"D	3'6" - 3'4"	
Short End Vertical	10	A-441	2 - 1.14"D	2 - 2'7 1/2"	
Short End Tension	11	A-441	1.14"D + .75"D	3'1" - 3'0"	

WORLD TRADE CENTER
FLOOR GRID TRUSSES
DESIGN DATA

TRUSS UNIT MARKED 2C32TC Refer to drawings ST101, 4, 5, 6, 8

Clearspan "L" = 34.93 ft. Spacing = 6.67 ft.

Applicable Total Moment = 4,730,000 inch pounds.

Based on 150 lbs./sq. ft. Total Load "W".
R = 65,000

Applicable End Reaction = 32,000 pounds.

Based on lbs./sq. ft. Total Load "W".

Applicable Total Constr. Moment = 1,053,000 inch pounds.

Based on 75 lbs./sq. ft. Construction Load.

Applicable Constr. End Reaction = 9360 pounds.

Based on 75 lbs./sq. ft. Construction Load.

"V" Shear at End Panel = pounds. ED = ft.

WEB MEMBER #1 Distance from End Panel = ft.

Applicable Shear V_x = 26,630 lbs. f_y = 50,000 psi

Slope = 2.45 f_s = 30,000 psi

l = in. f_{sc} = psi

Reqd. Area = 2.35 sq. in. Use 2-#7.5 Area = 2.72 sq. in.
2-#7.5

WEB MEMBER #2 Distance from End Panel = ft.

Applicable Shear V_x = 26,630 lbs. f_y = 50,000 psi

Slope = 1.00 f_s = psi

l = in. f_{sc} = 16,880 psi

Reqd. Area = 1.53 sq. in. Use 2-#1.14"D Area = 2.04 sq. in.

WEB MEMBER #3 Distance from End Panel = ft.

Applicable Shear V_x = 17,920 lbs. f_y = 50,000 psi

Slope = 1.162 f_s = psi

l = 29.5 in. f_{sc} = 13,870 psi

Reqd. Area = 1.51 sq. in. Use 2-#1.14"D Area = 2.04 sq. in.

WEB MEMBER #4 Distance from End Panel = ft.Applicable Shear $V_x = 48,760$ lbs. $f_y = 50,000$ psiSlope = 1.162 $f_B = \text{—}$ psi $l = 29.5$ in. $f_{sc} = 13,870$ psiReqd. Area = 4.08 sq. in. Use 2 - 1.14" DIA. Area = 4.08 sq. in.
+ 2 - 1.14" DIA.WEB MEMBER #5 Distance from End Panel = ft.Applicable Shear $V_x = 59,830$ lbs. $f_y = 50,000$ psiSlope = 1.45 $f_B = 30,000$ psi $l = \text{—}$ in. $f_{sc} = \text{—}$ psiReqd. Area = 2.90 sq. in. Use 2 - 1.14" DIA. Area = 2.92 sq. in.
+ 2 - 0.75" DIA.CHORD MEMBER #6 Consists of 4 - 2" x 1 1/2" x 0.31" AnglesConstruction Load Design Area = 4.30 sq. in.Applicable Moment = 1,053,000 in. lbs. $f_y = 50,000$ psi $l = 33.375$ in. $f_B = \text{—}$ psi $r_x = 0.45$ in. $f_{sc} = 19,080$ psi $r_z = 0.31$ in. (with fillers in middle 60% of span) $\frac{l}{r_x} = 77.2$ $\frac{l}{2r_z} = 53.8$

$$\frac{f_a}{F_a} + \frac{f_b C_m}{F_b (1 - \frac{f_a}{F_e})} = 0.508 \text{ less than } 1$$

 $f_a = 2,750$ psi $f_b = 19,080$ psi $f_c = 1,110$ psi $F_b = 30,000$ psi $F_e = 24,750$ psiUse 4 - 2" x 1 1/2" x 0.31" 4's Area = 4.30 sq. in.CHORD MEMBER #7 Consists of 4 - 3" x 2" x 0.37" AnglesTotal Load Design Area = 7.32 sq. in.

SPECIAL SECTIONS

(Extended, square ends, etc.)

MEMBER 9Slope = 1.162 $V_x =$ 17,920 lbs. $r_y =$ 50,000 psi $l =$ 27.5 in. $r_s =$ 36,000 psiReq'd. Area = .695 sq.in. Use 2-1.14"D Area 2.04 sq.in.MEMBER 10Slope = 1.00 $V_x =$ 59,830 lbs. $r_y =$ 50,000 psi $l =$ 25.5 in. $r_s =$ 36,000 psiReq'd. Area = 3.55 sq.in. Use 2-1.14"D Area 4.08 sq.in.MEMBER 11Slope = 1.162 $V_x =$ 56,700 lbs. $r_y =$ 50,000 psi $r_s =$ 36,000 psiReq'd. Area = 2.20 sq.in. Use 2-1.14"D Area 2.92 sq.in.

CHORD MEMBER #7 (CONTD.)

$$\text{Applicable Moment} = \underline{4,730,000} \text{ in lbs.} \quad f_y = \underline{36,000} \text{ psi}$$

$$D_c = \underline{33.00} \text{ in.}$$

$$f_s = \underline{22,000} \text{ psi}$$

$$f_{sc} = \underline{\quad\quad\quad} \text{ psi}$$

$$B_{eff} = \underline{64.00} \text{ in.}$$

$$t = \underline{4.00} \text{ in.}$$

$$y_1 = \underline{2.00} \text{ in.}$$

$$d_2 = \underline{5.69} \text{ in.}$$

$$y_2 = \underline{4.46} \text{ in.}$$

$$d_3 = \underline{22.29} \text{ in.}$$

$$y_3 = \underline{32.44} \text{ in.}$$

$$c_1 = \underline{10.15} \text{ in.}$$

$$d_1 = \underline{8.15} \text{ in.}$$

$$c_2 = \underline{22.85} \text{ in.}$$

$$I_s = \sum [(I_c + A_c d_1^2) + (I_{TCA} + A_{TCA} d_2^2) + I_{BCA} + A_{BCA} d_3^2]$$

$$\bar{y} = \frac{\sum (A_c y_1 + A_{TCA} y_2 + A_{BCA} y_3)}{\sum (A_c + A_{TCA} + A_{BCA})}$$

$$\bar{y} = \underline{10.15} \text{ in.}$$

$$I_s = \underline{4,927} \text{ in.}^4 \quad (\underline{2C32T6})$$

$$\text{Resisting Moment} = f_s \times \frac{I_s}{c_2} = \underline{4,740,000} \text{ in. lbs.}$$

$$\text{Use } \underline{4-3" \times 2" \times 0.37" \text{ L's}} \quad \text{Area} = \underline{7.32} \text{ sq. in.}$$

Composite Design Top Chord Check

Total Load Design

$$f_c = \underline{3,000} \text{ psi}$$

$$\text{Applicable Moment} = \underline{4,730,000} \text{ in. lbs.} \quad f'_c = \underline{1,350} \text{ psi}$$

$$f'_{cc} = \frac{M c_1}{15 I_s} = \underline{648} \text{ psi}$$

CHORD MEMBER #8

Consists of 4-2" x 1 1/2" x 0.31" Angles

$$\text{Area} = \underline{4.30} \text{ sq. in.}$$

(SAME AS MEMBER 6)

WORLD TRADE CENTER
BRIDGING TRUSSES
DESIGN DATA

TRUSS UNIT MARKED C 2BT7 Refer to drawings ST/04, 6.9

NEGATIVE MOMENT

CHORD MEMBER #6 Consists of 2 - 2" x 1 1/2" x 0.31" angles

Area = 2.15 sq. in.

$d_e = \underline{22.98}$ in.

$f_y = \underline{50,000}$ psi

$f_b = \underline{30,000}$ psi

$f_{bc} = \underline{\quad}$ psi

$$M = A_{TCA} f_b d_e = (2.15)(30,000)(22.98)$$

$$M = \underline{1,470,000} \text{ in lbs.}$$

CHORD MEMBER #7 Consists of 2 - 3" x 2" x 0.37" angles

Area = 3.66 sq. in.

$l = \underline{35.25}$ in.

$r_x = \underline{0.57}$ in.

$f_y = \underline{36,000}$ psi

$r_z = \underline{0.44}$ in.

$f_b = \underline{\quad}$ psi

$\frac{l}{r_x} = \underline{61.9}$

$f_{bc} = \underline{16,340}$ psi

$\frac{l}{2r_z} = \underline{80.2}$

(With fillers where required)

$d_e = \underline{22.98}$ in.

$$M = A_{BCA} f_{bc} d_e = (3.66)(16,340)(22.98)$$

$$M = \underline{1,374,000} \text{ in lbs.}$$

MAXIMUM NEGATIVE MOMENT = 1,374,000 in. lbs.

POSITIVE MOMENTCHORD MEMBER #7Consists of 2- 3" x 2" x 0.37" anglesArea = 3.66 sq. in.

$D_t = \underline{29.5}$ in. $r_y = \underline{36.000}$ psi
 $B_{eff} = \underline{64.0}$ in. $r_z = \underline{22.000}$ psi
 $r = \underline{4.00}$ in. $r_{oo} = \underline{\quad}$ psi
 $y_1 = \underline{2.00}$ in. $d_3 = \underline{22.25}$ in.
 $y_2 = \underline{5.96}$ in. $c_1 = \underline{6.69}$ in.
 $y_3 = \underline{28.94}$ in. $c_2 = \underline{22.81}$ in.
 $d_1 = \underline{4.69}$ in.
 $d_2 = \underline{0.73}$ in.

$$I_s = (I_c + A_c d_1^2) + (I_{TCA} + A_{TCA} d_2^2) + I_{BCA} + A_{BCA} d_3^2$$

$$\bar{y} = \frac{(A_c y_1 + A_{TCA} y_2 + A_{BCA} y_3)}{(A_c + A_{TCA} + A_{BCA})}$$

$$y = \underline{6.69}$$
 in.

$$I_s = \underline{2214}$$
 in.⁴ (C 2 RT 7)

$$\text{Resisting Moment} = f_s \times \frac{I_s}{c_2} = \underline{2,133,000}$$
 in. lbs.

Composite Design Top Chord Check

$$\text{Applicable Moment} = \underline{2,133,000}$$
 in. lbs. $f_c = \underline{3,000}$ psi

$$f'_{cc} = \frac{M c_1}{15 I_s} = \underline{430}$$
 psi $f'_c = \underline{1,350}$ psi

$$\text{Maximum Positive Moment} = \underline{2,133,000}$$
 in. lbs.

Design of Web

$$f_y = \underline{36,000}$$
 psi

$$\text{Use } \underline{0.92" \text{ DIA.}} \text{ Area} = \underline{0.67}$$
 sq. in.

CHORD MEMBER #7 (CONTD.)

Applicable Moment = 1,980,000 in lbs. $f_y = \underline{36,000}$ psi $f_s = \underline{22,000}$ psi $f_{sc} = \underline{\quad}$ psi $e_t = \underline{29.50}$ in. $e_{eff} = \underline{64.00}$ in. $t = \underline{4.00}$ in. $y_1 = \underline{2.00}$ in. $y_2 = \underline{5.96}$ in. $y_3 = \underline{28.94}$ in. $d_1 = \underline{4.69}$ in. $d_2 = \underline{0.73}$ in. $d_3 = \underline{22.25}$ in. $c_1 = \underline{6.69}$ in. $c_2 = \underline{22.81}$ in.

$$I_s = \sum [I_c + A_c d_1^2] + (I_{TCA} + A_{TCA} d_2^2) + I_{BCA} + A_{BCA} d_3^2$$

$$\bar{y} = \frac{\sum (A_c y_1 + A_{TCA} y_2 + A_{BCA} y_3)}{\sum (A_c + A_{TCA} + A_{BCA})}$$

 $\bar{y} = \underline{6.69}$ in. $I_s = \underline{2214}$ in.⁴ (C28T7)resisting Moment = $f_s \times \frac{I_s}{S_x} = \underline{2,133,000}$ in. lbs.Use 2 - 3" x 2" x 0.37" #5 Area = 3.66 sq. in.

Composite Design Top Chord Check

Total Load Design

 $f_c = \underline{3,000}$ psiApplicable Moment = 1,980,000 in. lbs. $f'_c = \underline{1,360}$ psi

$$f'_{cc} = \frac{M_{cl}}{15 I_B} = \underline{390}$$
 psi

CHORD MEMBER #8

Consists of 2 - 2" x 1 1/2" x 0.31" AnglesArea = 2.15 sq. in.

(SAME AS MEMBER 6)

WEB MEMBER #1

$R = 22,000 \text{ lbs.}$

$f_y = 50,000 \text{ psi}$

$V_1 = 21,000 \text{ lbs.}$

$f_s = 30,000 \text{ psi}$

$\text{Slope} = 2.07$

$f_{sc} = \text{---} \text{ psi}$

$\text{Reqd. Area} = 1.45 \text{ sq. in. Use } 2 \times 0.98" \text{ dia. Area} = 1.51 \text{ in.}^2$

WORLD TRADE CENTER
BRIDGING TRUSSES
DESIGN DATA

TRUSS UNIT MARKED C 28 T8 Refer to drawings ST 104, 6, 9

NEGATIVE MOMENT

CHORD MEMBER #6 Consists of 2 - 2" x 1 1/2" x 0.31" angles

Area = 2.15 sq. in.

$d_e =$ 22.98 in.

$f_y =$ 50,000 psi

$f_s =$ 30,000 psi

$f_{sc} =$ psi

$$M = A_T C A f_s d_e = (2.15)(30,000)(22.98)$$

$$M = \underline{1,470,000} \text{ in lbs.}$$

CHORD MEMBER #7 Consists of 2 - 3" x 2" x 0.37" angles

Area = 3.66 sq. in.

$l =$ 35.25 in.

$r_x =$ 0.57 in.

$f_y =$ 36,000 psi

$r_z =$ 0.44 in.

$f_s =$ psi

$\frac{l}{r_x} =$ 61.9

$f_{sc} =$ 16,340 psi

$\frac{l}{2r_z} =$ 80.2

(With fillers where required)

$d_e =$ 22.98 in.

$$M = A_{BCA} f_{sc} d_e = (3.66)(16,340)(22.98)$$

$$M = \underline{1,374,000} \text{ in lbs.}$$

MAXIMUM NEGATIVE MOMENT = 1,374,000 in. lbs.

POSITIVE MOMENTCHORD MEMBER #7Consists of 2 - 3" x 2" x 0.37" anglesArea = 3.66 sq. in. $D_t = \underline{29.5}$ in. $f_y = \underline{36,000}$ psi $R_{eff} = \underline{64.0}$ in. $f_b = \underline{22,000}$ psi $t = \underline{4.00}$ in. $f_{ax} = \underline{\hspace{1cm}}$ psi $y_1 = \underline{2.00}$ in. $y_2 = \underline{5.96}$ in. $d_3 = \underline{22.25}$ in. $y_3 = \underline{28.94}$ in. $c_1 = \underline{6.69}$ in. $d_1 = \underline{4.69}$ in. $c_2 = \underline{22.81}$ in. $d_2 = \underline{0.73}$ in.

$$I_B = (I_c + A_c d_1^2) + (I_{TCA} + A_{TCA} d_2^2) + I_{BCA} + A_{BCA} d_3^2$$

$$\bar{y} = \frac{(A_c y_1 + A_{TCA} y_2 + A_{BCA} y_3)}{(A_c + A_{TCA} + A_{BCA})}$$

 $y = \underline{6.69}$ in. $I_B = \underline{2.214}$ in.⁴ (C 2878)Resisting Moment = $f_b \times \frac{I_B}{c_2} = \underline{2,133,000}$ in. lbs.Composite Design Top Chord CheckApplicable Moment = 2,133,000 in. lbs. $f_c = \underline{3,000}$ psi $f'_{cc} = \frac{M c_1}{I_{B1}} = \underline{430}$ psi $f'_c = \underline{1,350}$ psiMaximum Positive Moment = 2,133,000 in. lbs.

Design of Web

 $f_y = \underline{36,000}$ psiUse 0.92" DIA. Area = 0.67 sq. in.

CHORD MEMBER #7 (CONTD.)

Applicable Moment = 2,090,000 in lbs. $f_y = \underline{36,000}$ psi $D_t = \underline{29.50}$ in. $f_b = \underline{22,000}$ psi $B_{eff} = \underline{64.00}$ in. $f_{sc} = \underline{\quad}$ psi $t = \underline{4.00}$ in. $y_1 = \underline{2.00}$ in. $d_2 = \underline{0.73}$ in. $y_2 = \underline{5.96}$ in. $d_3 = \underline{22.25}$ in. $y_3 = \underline{28.94}$ in. $c_1 = \underline{6.69}$ in. $d_1 = \underline{4.69}$ in. $c_2 = \underline{22.81}$ in.

$$I_s = \sum [(I_c + A_c d_1^2) + (I_{TCA} + A_{TCA} d_2^2) + I_{BCA} + A_{BCA} d_3^2]$$

$$\bar{y} = \frac{\sum (A_c y_1 + A_{TCA} y_2 + A_{BCA} y_3)}{\sum (A_c + A_{TCA} + A_{BCA})}$$

 $\bar{y} = \underline{6.69}$ in. $I_s = \underline{2214}$ in.⁴ (C28T8)Resisting Moment = $f_s \times \frac{I_s}{c_2} = \underline{2,133,000}$ in. lbs.Use 2-3" x 2" x 0.37" ~~Angles~~ Area = 7.32 sq. in.

Composite Design Top Chord Check

Total Load Design

 $f_c = \underline{3,000}$ psiApplicable Moment = 2,090,000 in. lbs. $f'_c = \underline{1,350}$ psi

$$f'_{cc} = \frac{M_{cl}}{15I_s} = \underline{421}$$
 psi

CHORD MEMBER #8

Consists of 2-2" x 1½" x 0.31" AnglesArea = 2.15 sq. in.

(SAME AS MEMBER 6)

WORLD TRADE CENTER
BRIDGING TRUSSES
DESIGN DATA

TRUSS UNIT MARKED C 2 B T 9 Refer to drawings ST 104.6.9

NEGATIVE MOMENT

CHORD MEMBER #6 Consists of 2 - 2" x 1/2" x 0.31" angles
Area = 2.15 sq. in.

$d_e = \underline{22.98}$ in. $f_y = \underline{50,000}$ psi
 $f_a = \underline{30,000}$ psi
 $f_{sc} = \underline{\quad\quad}$ psi

$$M = A_{TCA} f_s d_e = (2.15)(30,000)(22.98)$$

$$M = \underline{1,470,000} \text{ in lbs.}$$

CHORD MEMBER #7 Consists of 2 - 3" x 2" x 0.37" angles
Area = 3.66 sq. in.

$l = \underline{35.25}$ in.
 $r_x = \underline{0.57}$ in. $f_y = \underline{36,000}$ psi
 $r_z = \underline{0.44}$ in. $f_c = \underline{\quad\quad}$ psi
 $\frac{l}{r_x} = \underline{61.9}$ $f_{sc} = \underline{16,340}$ psi
 $\frac{l}{2r_z} = \underline{80.2}$ (With fillers where required)
 $d_e = \underline{22.98}$ in.

$$M = A_{BCA} f_{sc} d_e = (3.66)(16,340)(22.98)$$

$$M = \underline{1,374,000} \text{ in lbs.}$$

MAXIMUM NEGATIVE MOMENT = 1,374,000 in. lbs.

POSITIVE MOMENTCHORD MEMBER #7Consists of 2-3"x2"x0.37" anglesArea = 3.66 sq. in. $D_t = \underline{29.5}$ in. $f_y = \underline{36,000}$ psi $B_{eff} = \underline{64.0}$ in. $f_s = \underline{22,000}$ psi $t = \underline{4.00}$ in. $f_{ao} = \underline{\quad}$ psi $y_1 = \underline{2.00}$ in. $y_2 = \underline{5.96}$ in. $d_3 = \underline{22.25}$ in. $y_3 = \underline{28.94}$ in. $c_3 = \underline{6.69}$ in. $c_1 = \underline{4.69}$ in. $c_2 = \underline{22.81}$ in. $d_2 = \underline{0.73}$ in.

$$I_B = (I_c + A_c d_1^2) + (I_{TCA} + A_{TCA} d_2^2) + I_{BCA} + A_{BCA} d_3^2$$

$$\bar{y} = \frac{(A_c y_1 + A_{TCA} y_2 + A_{BCA} y_3)}{(A_c + A_{TCA} + A_{BCA})}$$

 $y = \underline{6.69}$ in. $I_B = \underline{2,214}$ in.⁴ (C28T9)

$$\text{Resisting Moment} = f_s \times \frac{I_B}{c_2} = \underline{2,133,000} \text{ in. lbs.}$$

Composite Design Top Chord CheckApplicable Moment = 2,133,000 in. lbs. $f_c = \underline{3,000}$ psi


$$f'_{cc} = \frac{M c_1}{I_B} = \underline{430} \text{ psi} \quad f'_c = \underline{1,350} \text{ psi}$$

Maximum Positive Moment = 2,133,000 in. lbs.

Design of Web

 $f_y = \underline{36,000}$ psiUse 0.92" DIA. Area = 0.67 sq. in.


LACLEDE STEEL COMPANY SAINT LOUIS, MISSOURI
 DRAWING NO. ST 111 SUBJECT COVER PLATE DETAILS
 BY: W.H. DATE 3-6-87 WORLD TRADE CENTER TOWERS
 CHKD. BY ACW DATE 3-7-87 NEW YORK N.Y.

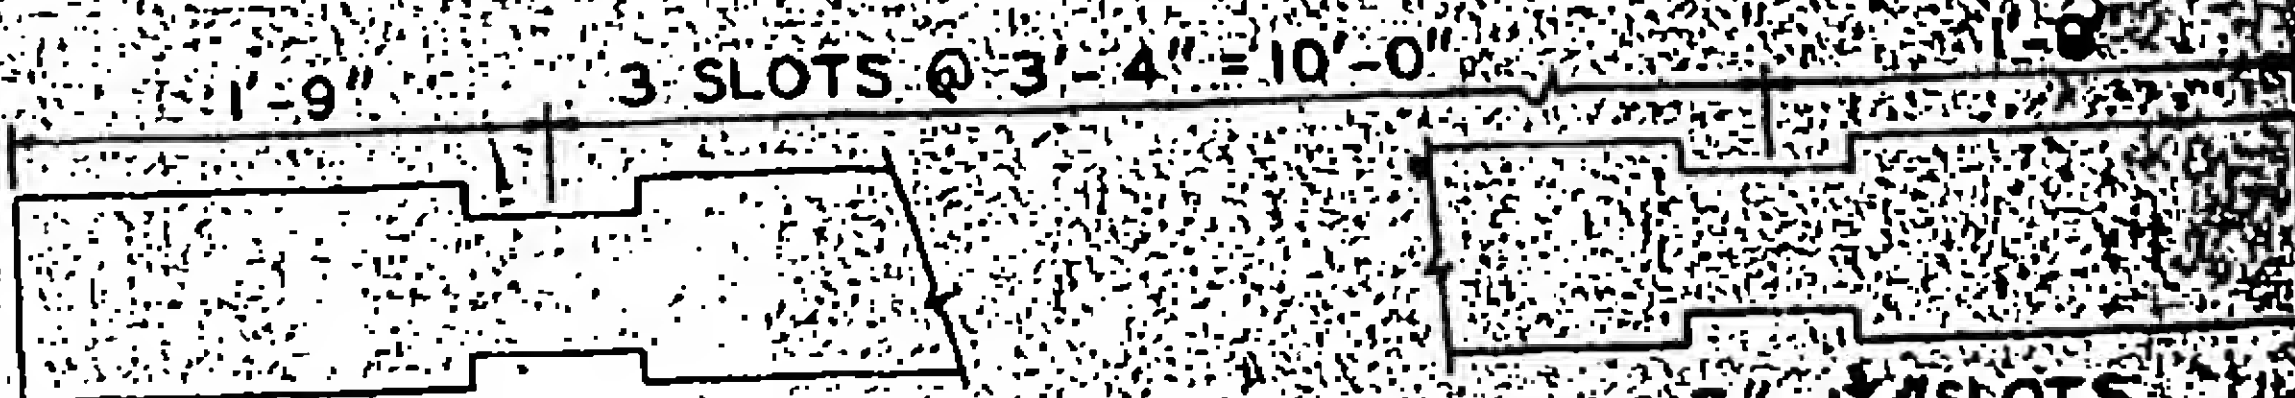

TYPE A 13'-6" LG

8 1/2" WIDE A }
 6 1/2" WIDE A } 0.135 MIN. THICKNESS


17280 PCS 13'-6" LONG TYPE A REQUIRED
 2880 " " " " " " " " " " " "

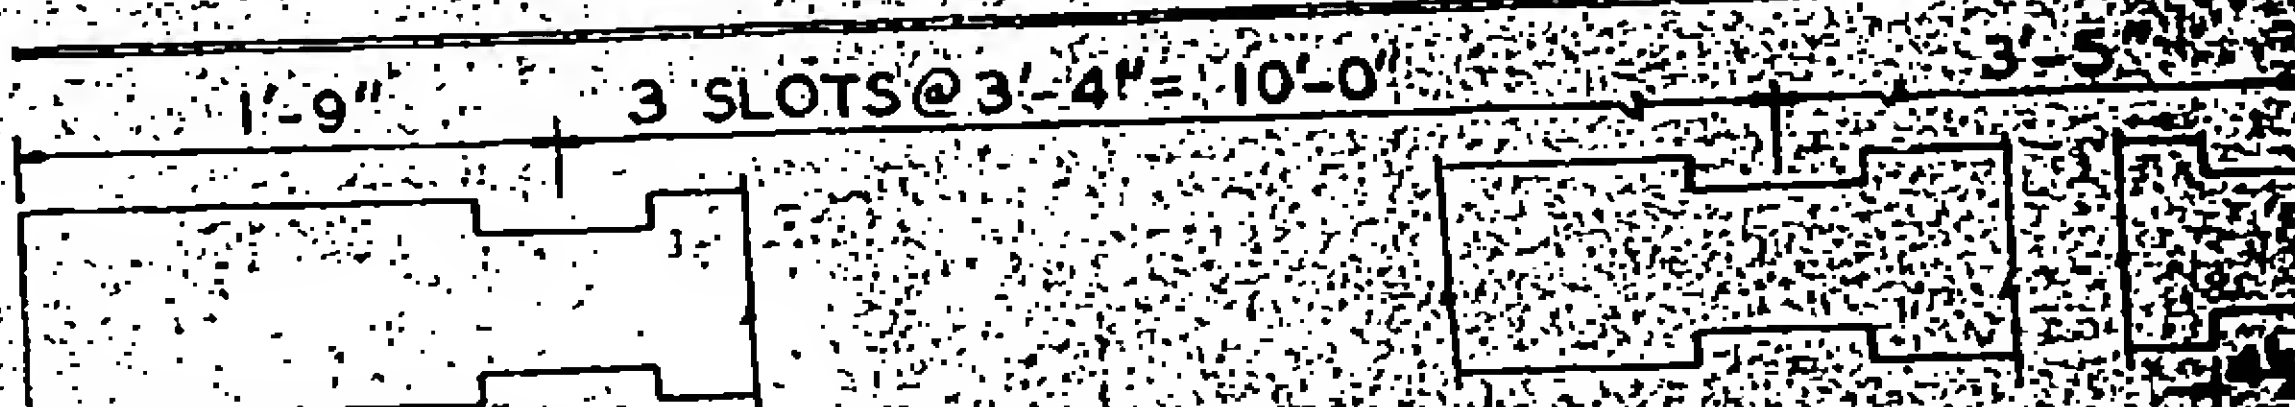

TYPE B 15'-2" LG

8 1/2" WIDE B }
 6 1/2" WIDE B } 0.135 MIN. THICKNESS

17280 PCS 15'-2" LONG TYPE B REQUIRED
 2880 " " " " " " " " " " " "

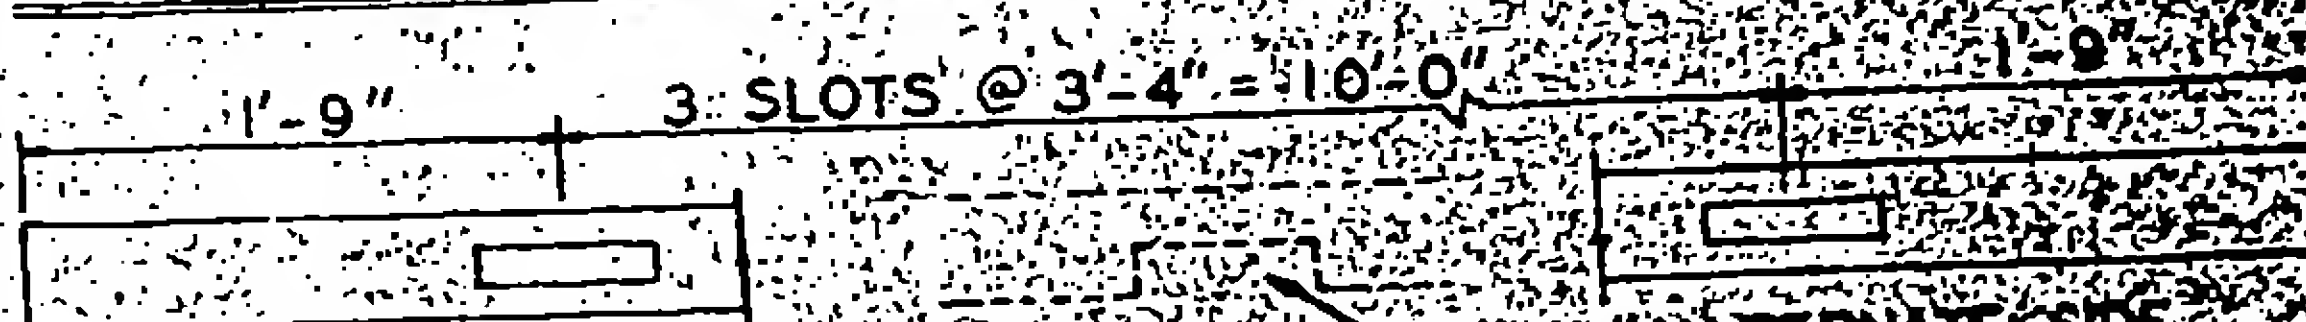

TYPE C 13'-6" LG

4" WIDE
 0.135 MIN. THICKNESS

1440 PCS 13'-6" LONG TYPE C REQUIRED

LACLEDE STEEL COMPANY SAINT LOUIS, MISSOURI

DRAWING NO. ST 112

SUBJECT COVER PLATES DETAILS

BY L.W.H.


DATE 3-6-67

WORLD TRADE CENTER TOWERS

CHKD. BY ACW

DATE 3-7-67

NEW YORK, N.Y.

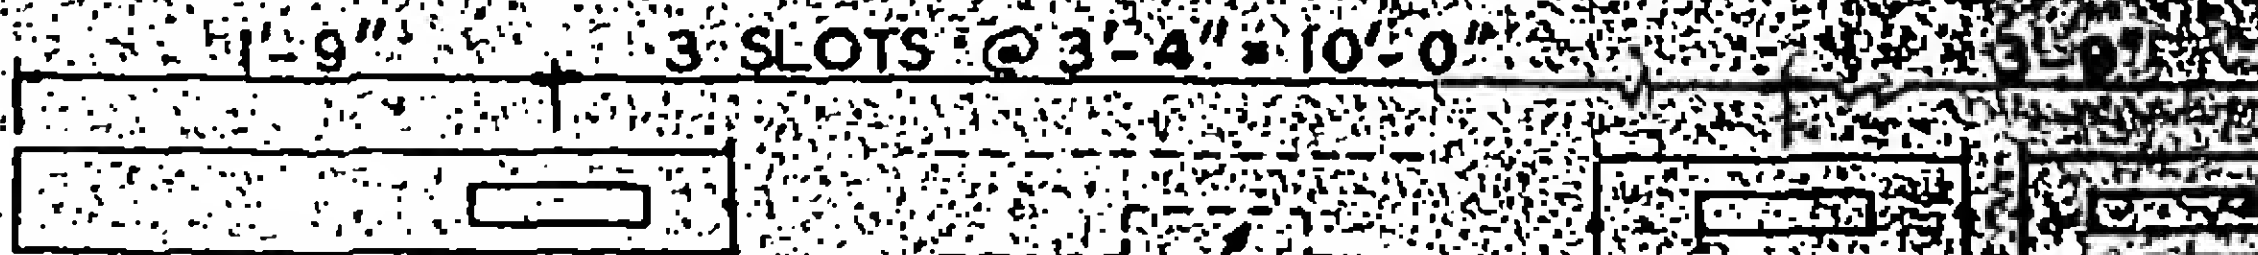


7"x1 1/2" SLOTS (CENTERED)

7"x2" (ALTERNATE SIDE DESIGN)

TYPE D 15'-6" LG

4" WIDE .0135 MIN. THICKNESS

1440 PCS 15'-6" LONG TYPE D REQUIRED

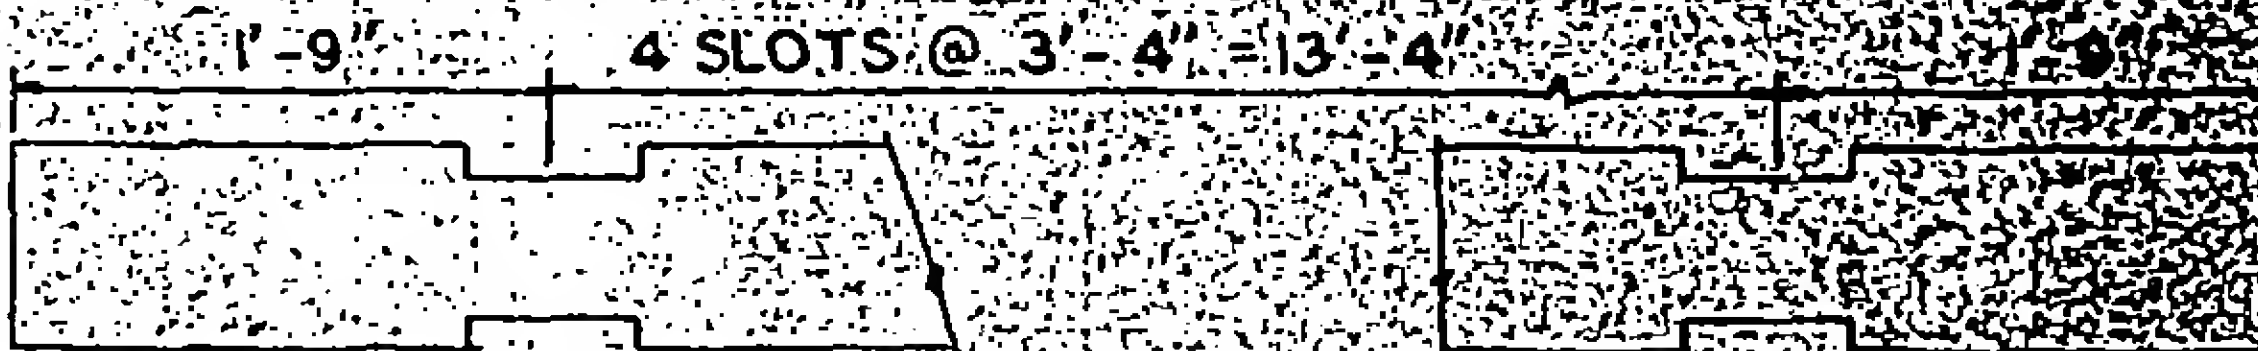


7"x1 1/2" SLOTS

TYPE E 16'-10" LG

6 1/2" WIDE .0135 MIN. THICKNESS

9640 PCS 16'-10" LONG

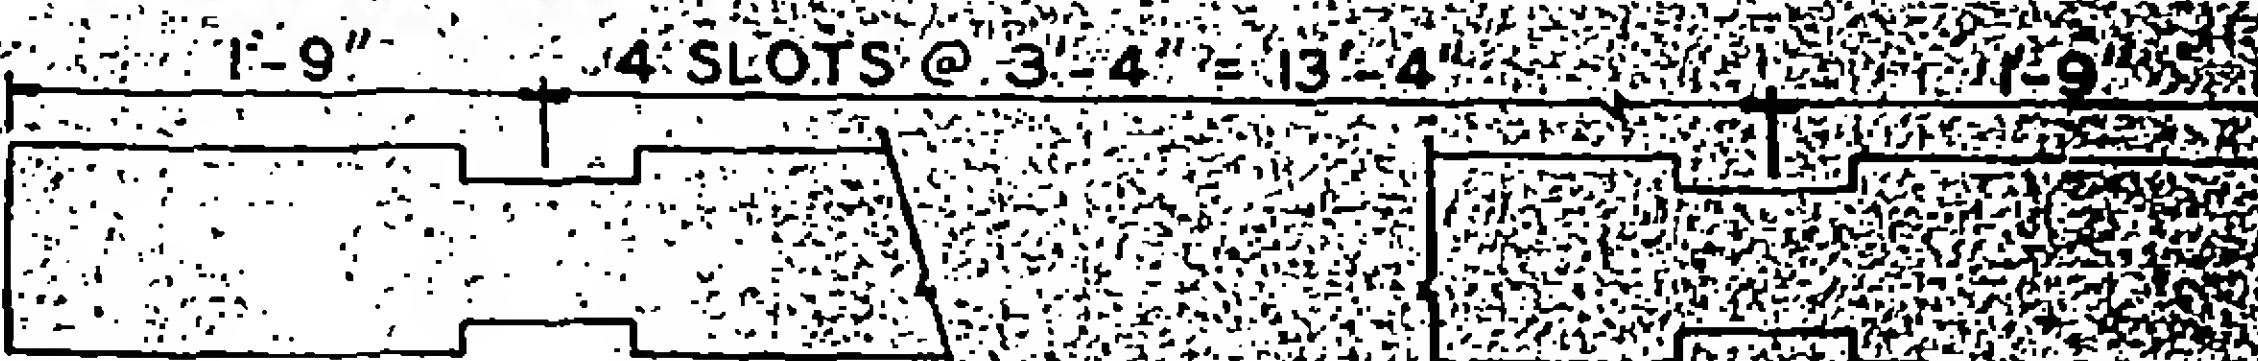

7"x1 1/2" SLOTS

TYPE F 16'-10" LG

8 1/2" WIDE .0135 MIN. THICKNESS

1440 PCS 16'-10" LONG TYPE F REQUIRED

LACLEDE STEEL COMPANY
STRUCTURAL DETAILS
WORLD TRADE CENTER TOWERS
PORT OF NEW YORK AUTHORITY

<u>Detail No.</u>	<u>Title</u>	<u>Date Transmitted</u>	<u>Approved</u>
ST-101	Typical 32" composite truss web Intermediate Panel - Full Scale		
ST-102	Typical web chord sections 32" composite trusses - Full Scale		
ST-103	Intermediate panel details 24" standard trusses 32" composite trusses - Full Scale		
ST-104	Intermediate panel details 28" composite trusses 32" composite trusses - Full Scale		
ST-105	Corner intersection details Continuity of 32" - 60' span composite trusses (CT3, CT3A and CT4) into 28" composite trusses (CT9) in 35' span - Full Scale		
ST-106	Typical column bearing end detail of 32" composite trusses 2" x 2" damping unit extension Scale $\frac{1}{2}$ " = 1"		
ST-106A	Column bearing end detail showing diagonal angle bracing attachment 32" composite trusses Scale $\frac{1}{2}$ " = 1"		
ST-106B	Column bearing end detail Typical extended shallow bearing end - 32" composite trusses Scale $\frac{1}{2}$ " = 1"		
ST-106C	Column bearing end detail showing damping unit extension for 28" composite trusses 24" standard trusses Scale $\frac{1}{2}$ " = 1"		

<u>Detail No.</u>	<u>Title</u>	<u>Date Transmitted</u>	<u>Approved</u>
ST-106D	Column bearing end detail showing diagonal angle bracing attachment 28" composite trusses 24" standard trusses Scale $\frac{1}{4}" = 1"$		
ST-106E	Column bearing end detail typical extended shallow bearing end 28" composite trusses 24" standard trusses Scale $\frac{1}{4}" = 1"$		
ST-107	32" composite truss details Approximate 60' span Type CT1, CT2, CT3, CT3A and CT4 - Scale $1\frac{1}{4}" = 1'0"$		
ST-108	32" composite truss details Approximate 35' span Type CT5 and CT6 Scale $1\frac{1}{4}" = 1'0"$		
ST-109	28" composite truss details Corner construction Type CT7, CT8 & CT9 Scale $1\frac{1}{4}" = 1'0"$		
ST-110	24" standard truss details 20'0" transverse ST8, ST10, ST11 and ST12 (duct) 13'4" transverse ST13 Scale $1\frac{1}{4}" = 1'0"$		
ST-111	Cover plate details .0135" plates A, B, and C		
ST-112	Cover plate details .0135" plates D, E, and F		

<u>Detail No.</u>	<u>Title</u>	<u>Date Transmitted</u>	<u>Approved</u>
ST-113	32" composite truss details Typical column end bearing details - trusses CT1, 2, 3, 3A, 4, 5, and 6 Core end details 58'5", 58'3", and 57'7" spans - trusses CT1 and 2 - Full Scale		
ST-114	32" composite truss details Core end bearing details 59'9" and 59'8" spans - trusses CT1 and 2 - Full Scale		
ST-115	32" composite truss details Core end bearing details 59'3", 59'2", and 58'11" spans Trusses CT1 and 2 - Full Scale		
ST-116	32" composite truss details Core end bearing details Trusses CT5 and CT6 35'8" span Full Scale		
ST-117	28" composite truss details Truss CT7 - 19'6" span 24" standard truss details Truss ST10 - 19'6" span Column end bearing detail Full Scale		

LACLEDE STEEL COMPANY
FLOOR GRID PANEL & PANEL LOCATIONS
WORLD TRADE CENTER TOWERS
PORT OF NEW YORK AUTHORITY

<u>Detail No.</u>	<u>Title</u>	<u>Date Transmitted</u>	<u>Approved</u>
L-100	Typical floor plan - showing panel designation, truss location, applicable design moments and end reaction for truss design - Scale 1/8" = 1'0"	-	-
L-101	Quarter plan - Typical floor showing panel designation, truss location, truss designation and truss web configuration Scale 1/8" = 1'0"		

LACLEDE STEEL COMPANY
DESIGN CALCULATIONS
WORLD TRADE CENTER TOWERS
PORT OF NEW YORK AUTHORITY

<u>Sheet No.</u>	<u>Design Data</u>	<u>Date Transmitted</u>	<u>Approved</u>
D100-1 thru 7	Basic Design Data		
D101	Chord Angle Properties 2" x 1 1/2" angles		
D102	Chord Angle Properties 3" x 2" angles		
D103	Miscellaneous Section Properties		
D104	Miscellaneous Section Properties		
D105-T1	Design Data Truss Mk. 2C32T1		
D105-T2	Design Data Truss Mk. 2C32T2		
D105-T3	Design Data Truss Mk. 2C32T3		
D105-T3A	Design Data Truss Mk. 2C32T3A		
D105-T4	Design Data Truss Mk. 2C32T4		
D105-T5	Design Data Truss Mk. 2C32T5		
D105-T6	Design Data Truss Mk. 2C32T6		
D105-T7	Design Data Truss Mk. 2C32T7		
D105-T8	Design Data Truss Mk. C28T8		
D105-T9	Design Data Truss Mk. C28T9		
D105-T10	Design Data Truss Mk. S24T10		
D105-T11	Design Data Truss Mk. S24T11		
D105-T12	Design Data Truss Mk. S24T12		
D105-T13	Design Data Truss Mk. S24T13		
D105-ET1	Design Data Extended End Truss Mk. 2C32ET1		
D105-ET2	Design Data Extended End Truss Mk. 2C32ET2		
D105-ET3	Design Data Extended End Truss Mk. 2C32ET3		

<u>Sheet No.</u>	<u>Design Data</u>	<u>Date Transmitted</u>	<u>Approved</u>
D105-ET3A	Design Data Extended End Truss Mk. 2C32ET3A		
D105-ET4	Design Data Extended End Truss Mk. 2C32ET4		
D105-ET5	Design Data Extended End Truss Mk. 2C32ET5		
D105-ET6	Design Data Extended End Truss Mk. 2C32ET6		
D105-ET7	Design Data Extended End Truss Mk. C28ET7		
D105-ET10	Design Data Extended End Truss Mk. S24ET10		

WORLD TRADE CENTER
FLOOR GRID TRUSSES
BASIC DESIGN DATA

Based on double truss units. Mark 2CT__ or 2ST__.
Single truss components. Mark CT__ or ST__.

DIMENSIONS:

Unless specifically noted otherwise, see "ST" Details.

Truss clearspan in feet = L. Overall length of truss minus
end bearings in feet (2 x 5" = 10"). Example: 59'9" overall
~~length - 10" = 58'11" or 58'11" or 58'11"~~

Length of member, clear of attachments = "L"

Depth of Truss

Composite type "C" (Measured top of shear member to bottom
of lower chord.)

Standard type "S" (Measured out to out of chord members.)

Total depth of composite section = "D_t"

TOLERANCES:

Overall length 1/4" + or 1/4" -.

Depth 1/8" + or 1/8" -.

LOADS:

Total load = Live load + Dead load

Applicable for composite design.

Applicable for combined slab and top chord design and
bottom chord design.

Construction load = Applicable Dead load

Applicable for top and bottom chord steel design.

Dead load = Actual weight of structural system in pounds per
square foot.

Live load = Assigned live load for panel area in pounds per
square foot.

Design load in pounds per square foot = "W"

Date February 6, 1967

Applicable design load in pounds per foot equals design load in pounds per square foot times spacing of trusses in feet = "W"

TOTAL MOMENT:


"M" (In inch pounds) = $WL^2 \times 1.5$.

END REACTION:

"R" (In pounds) = "W" x L (Overall length of truss in feet).

SHEAR:

At first top chord panel in pounds = $V = R - (W \times ED)$

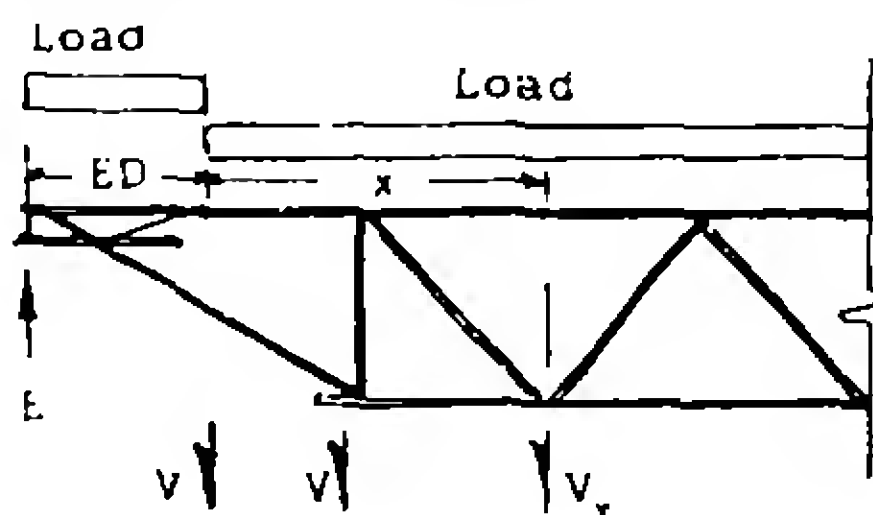


ED = Distance first top chord panel point to truss end.

Shear at other points in pounds = $V_x = (R - ED \times W) - W$ (distance to first top chord panel point in feet).

(In no case less than 50% of end reaction "R".)

IDENTIFICATION OF MEMBERS.

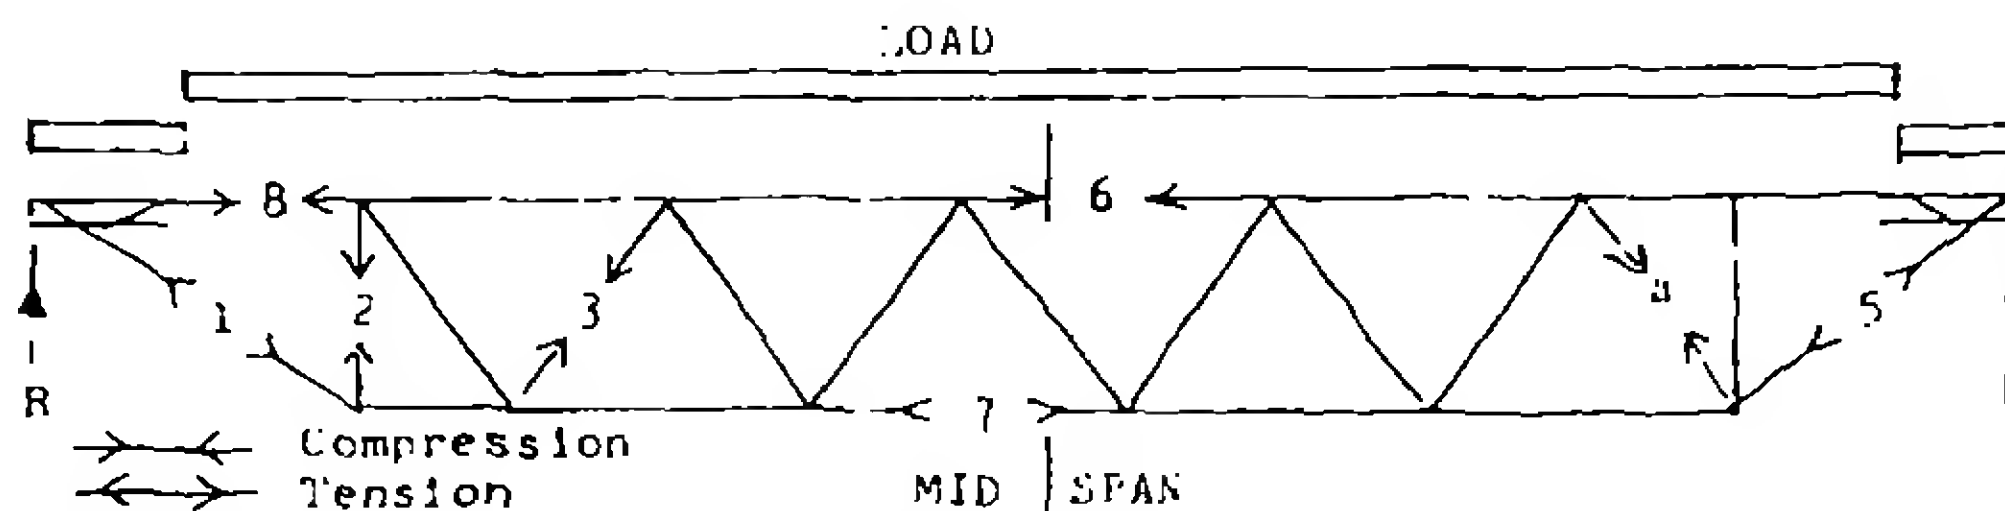

1. End diagonal (long end) tension member
2. First panel vertical (long end) compression
3. Second panel compression diagonal
4. First panel vertical (short end) compression
5. End diagonal (short end) tension.
6. Top chord critical compression member at mid span
7. Bottom chord critical tension member at mid span
8. End top chord compression member (long end)

MATERIALS:

A-36 steel 36 ksi minimum yield strength

LACLEDE STEEL COMPANY

D100-3
Date February 6, 1967

A-441 modified 50 ksi minimum yield strength
low alloy "H" Series.

See sheets D101 through D103 for Properties of Sections.

APPLICABLE FORMULAE: Stress Determination (Web or Chord Members)

A-36 steel

(36 ksi minimum yield) f_y = Minimum Yield Strength 36,000 psi
 f_s = Tension 22,000 psi
 f_{sc} = Compression for $l/r < 127$ $18,540 - .574 (l/r)^2$ psi
for $l/r > 127$ $\frac{149,000,000}{(l/4)^2}$ psi

~~l~~ = clear distance between attachments
 r = least radius of gyration

A-441 steel

(50 ksi minimum yield) f_y = Minimum Yield Strength 50,000 ksi
 f_s = Tension 30,000 psi
 f_{sc} = Compression for $l/r < 108$ $25,750 - 1.108 (l/r)^2$ psi
for $l/r > 108 < 200$ $\frac{149,000,000}{(l/r)^2}$ psi

Continuous members shall be designed for only axial compressive stress when the panel length clear of attachments does not exceed 24". When the panel length clear of attachments exceeds 24", the top chord shall be designed as a continuous member subject to combined axial and bending stress and shall be of proportion that the quantity -

$$\frac{f_a}{30,000} + \frac{f_b}{F_b}$$

does not exceed unity at the panel point, or that the quantity -

$$\frac{f_a}{F_a} + \frac{f_b C_m}{F_b (1 - \frac{f_a}{F'_e})}$$

does not exceed unity at the mid panel.

Permissible axial unit compressive stress = " F_a "

Permissible bending unit stress = " F_b "

Permissible compressive stress factor (column equation

$$\frac{149,000,000}{(l/r)^2} \text{ psi) = } "F'_e"$$

Actual axial unit compressive stress = f_a
 Actual bending unit stress = f_b

MAXIMUM SLENDERNESS RATIOS:

Top chord panels (interior) = 85
 Top chord end panels = 120
 Compression members other than top chord = 200
 Tension members = 240

FILLERS OR TIES:

Members in compression composed of two components shall have fillers or ties spaced so that the ratio of L/r of each component shall not exceed the ratio of L/r of the whole member. The minimum "r" shall be used in calculating the critical ratio L/r of any component.

SHEAR CONNECTORS:

Shall be considered to provide a minimum 15 ksi horizontal shear per web end connector imbedded in the concrete. This is for 3,000 psi concrete. (f_c)

DEFLECTION:

Applicable deflection formula for uniform load.

Maximum deflection $\Delta = \frac{25.88 (WL^4)}{29,000,000I}$

COMPOSITE SLAB AND JOIST DESIGN:Design values

Total depth of combined slab and truss in inches = D_t
 Effective width of concrete flange in inches equal to $2 \times B_t =$ B_{eff}
 Distance from top of concrete flange to neutral axis of concrete flange = y_1
 Distance from top of concrete flange to neutral axis of top chord angles = y_2
 Distance from top of concrete flange to neutral axis of bottom chord angles = y_3
 Distance from top of concrete flange to neutral axis of composite section = y
 Distance from neutral axis of composite section to neutral axis of concrete flange = d_1

Date February 6, 1967

Distance from neutral axis of composite section to neutral axis of top chord angles = d_2

Distance from neutral axis of composite section to neutral axis of bottom chord angles = d_3

Distance from neutral axis of composite section to outermost fibers of compression chord = c_1

Distance from neutral axis of composite section to outermost fibers of tension chord = c_2

Allowable concrete strength $f_c = 4,000$ pounds psi.

Allowable steel strength = f_s

~~Allowable concrete strength $f'_c = 1,250$ pounds psi~~

Actual concrete compressive stress = f'_{cc}

Allowable steel compressive stress = f_{sc}

Modular ratio = 15 = $\frac{E_s}{E_c}$

SECTION PROPERTIES. (Refer to Sheets D101 through D103)

Moment of inertia of concrete = I_c

Moment of inertia of top chord angles = I_{TCA}


Moment of inertia of bottom chord angles = I_{BCA}

Moment of inertia of composite system = I_s

Area of concrete flange = A_c

Area of top chord angles = A_{TCA}

Area of bottom chord angles = A_{BCA}

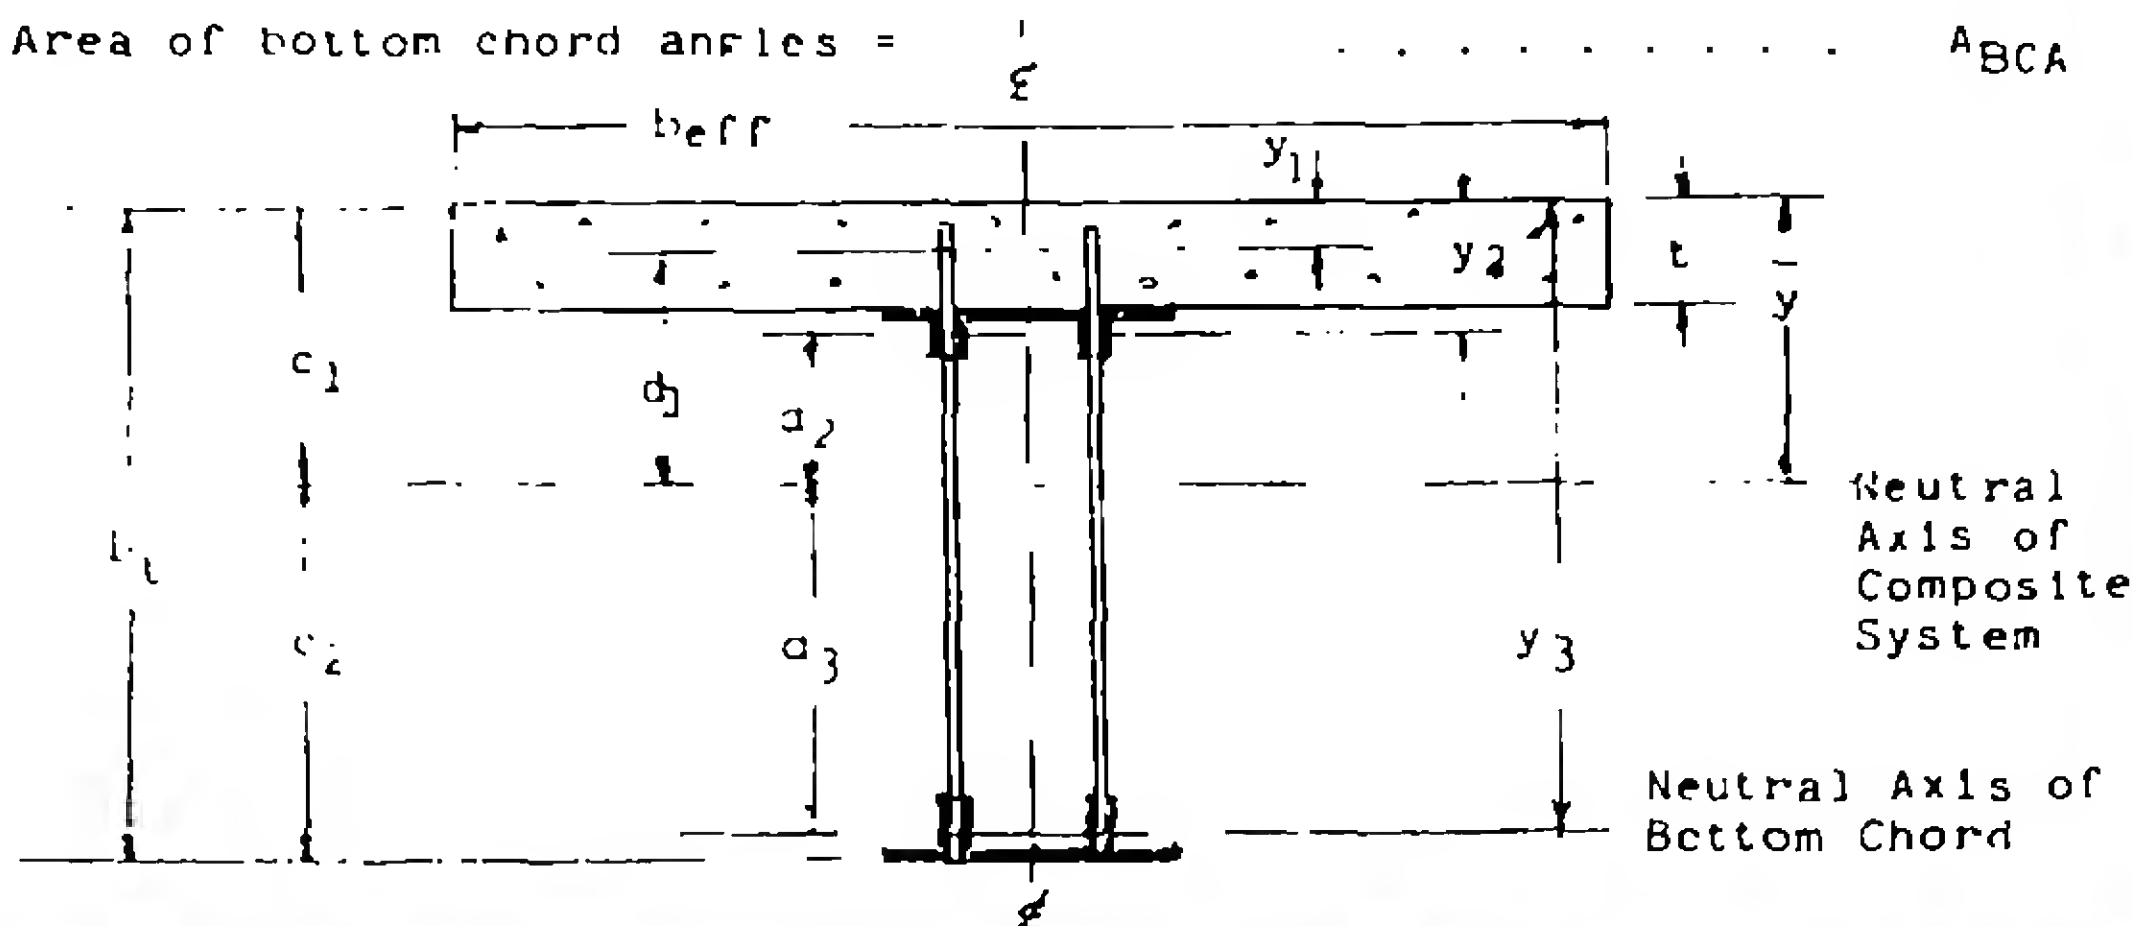

Date February 6, 1967

FORMULAE:

Resisting moment = "RM"

Allowable unit stress times the applicable Section Modulus =
(applicable $f \times S$).

Section Modulus (about the axis of bending) = $S = \frac{I}{C_1 \text{ or } C_2}$

QUALITY CONTROL AND INSPECTION:Material Test Reports

Since all steel employed in the fabrication of trusses is produced in the furnaces and mills of Laclede Steel Company, certified mill test reports showing heat numbers, chemistry, and physical properties for all steel employed will be provided.

Resistance Welding

Truss panel points will be connected by electronically controlled resistance welding providing two times the strength of the connected members at full design load.

Angle chords of carbon and alloy steel to be of weldable grade with contact surfaces cleaned of scale by shot blasting prior to welding.

Welds to be subject to "on-line" testing by measured hydraulic wedge action tester with spot checking of finished panel point welds by testing in vertical double shear to two times design load value.

Any panel point welds indicated to have less than the established factor for weld shear strength will be arc welded, subsequent to testing.

Full design load tests will be effected on full size and full length truss components by hydraulic loading in a test frame with load measurement by electric load cell and center span deflection check.

Load tests with recorded deflection and recovery data will be made on a minimum of one of each identified truss style involved in the panel construction.

Physical Tension Tests

Tension tests on truss components, chord angles, and webs will be performed on selected sample members included in the normal truss fabrication.

Inspection and Access to Plant

Free access to the plant of the truss manufacturer and the

LACLEDE STEEL COMPANY

D100-7

Date February 6, 1967

available inspection and test facilities will be offered the qualified inspectors representing the purchaser for observation of the test and inspection procedures outlined herein.

Any testing requested beyond that identified herein shall be for the account of the purchaser.




LACLEDE STEEL COMPANY SAINT LOUIS, MISSOURI

DRAWING NO. D101
 BY L.J.S. DATE 2-6-67
 CHKD BY ACW DATE 2-7-67

SUBJECT WORLD TRADE CENTER TOWERS
 THE PORT OF NEW YORK AUTHORITY

TRUSS SECTION COMPONENTS
 TRUSS ANGLE SECTIONS
 DESIGN SECTION PROPERTIES

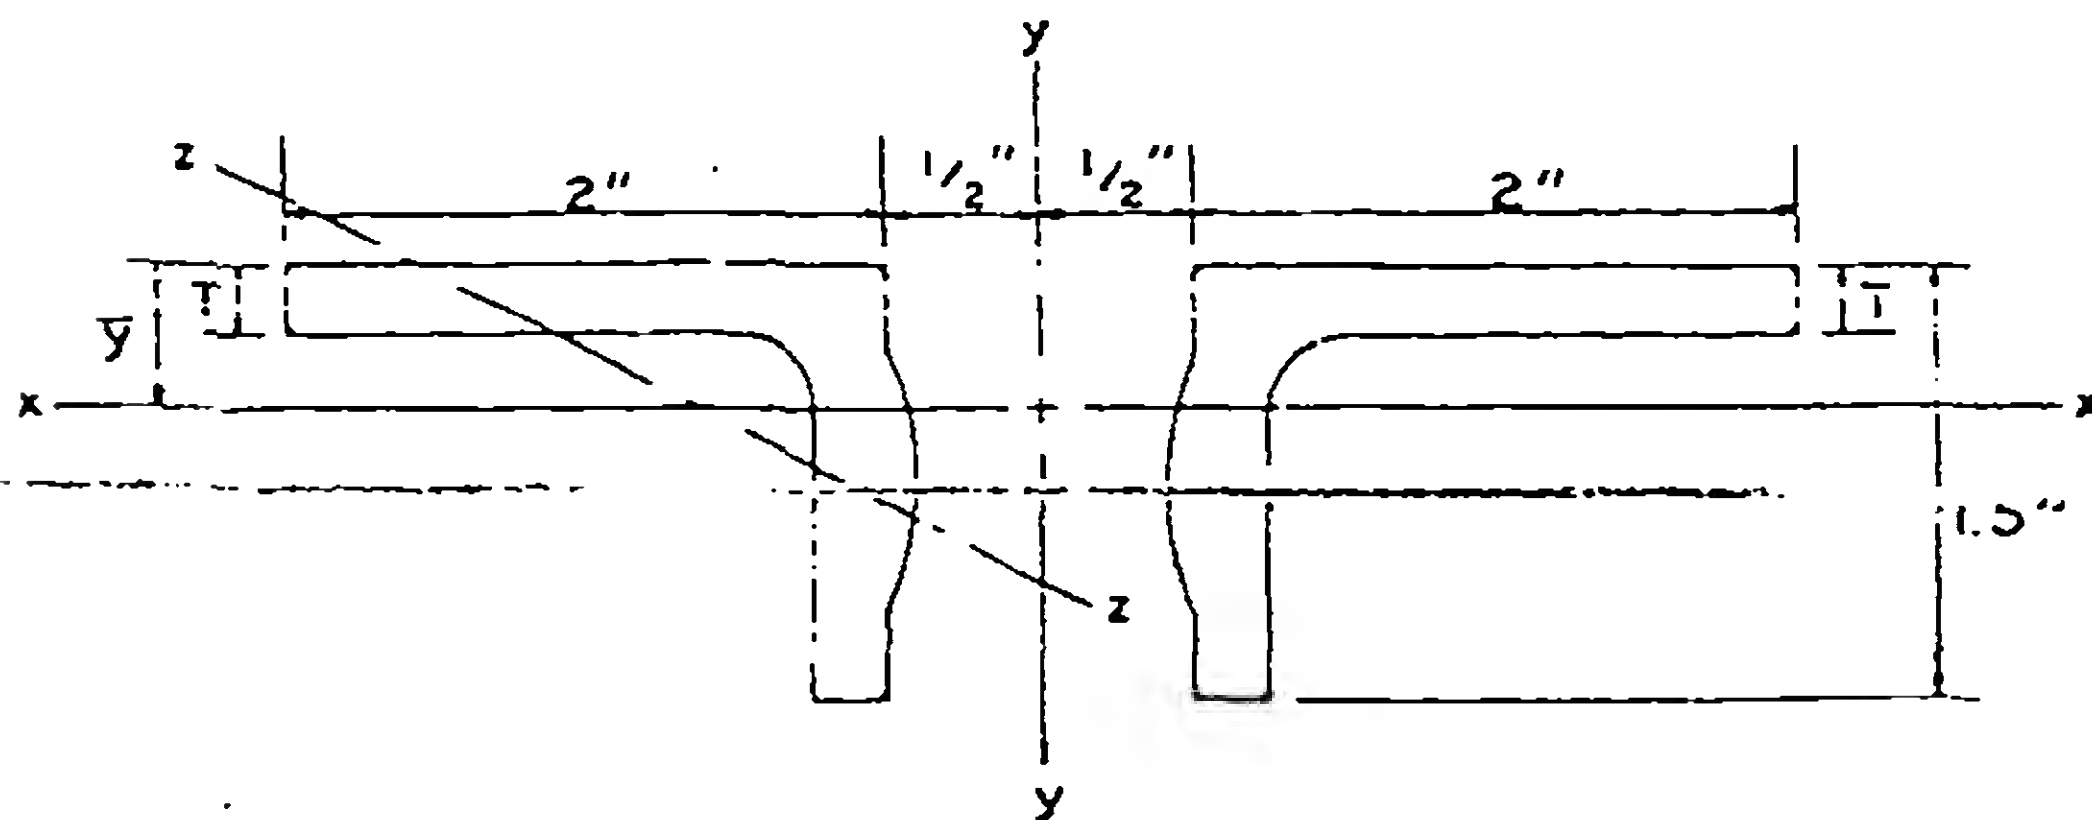


2"x 1 1/2" x T

T	1.50 in	1.50 in	0.37 in	1 1/2 - 1 1/2 - 23	
AREA	1.50 in ²	1.50 in ²	2.48	1.24	
\bar{y}	0.44 in	0.44 in	0.48	0.28	
I_x	0.04 in ⁴	0.04 in ⁴	0.45	0.18	
I_y	0.04 in ⁴	0.04 in ⁴	3.24		
r_x	0.44 in	0.44 in	0.42	0.35	
r_y	1.05 in	1.05 in	1.13		
r_z (ONE ANGLE)	0.72 in	0.72 in	0.29	0.26	
LBS/FT (TWO ANGLES)	7.50	7.50			



LACLEDE STEEL COMPANY SAINT LOUIS, MISSOURI
 DRAWING NO. D102..... SUBJECT WORLD TRADE CENTER TOWERS
 BY L.J.S. DATE 2-6-57 THE PORT OF NEW YORK AUTHORITY
 CHKD. BY A.C.W. DATE 2-7-57

TRUSS SECTION COMPONENTS
 TRUSS ANGLE SECTIONS
 DESIGN SECTION PROPERTIES

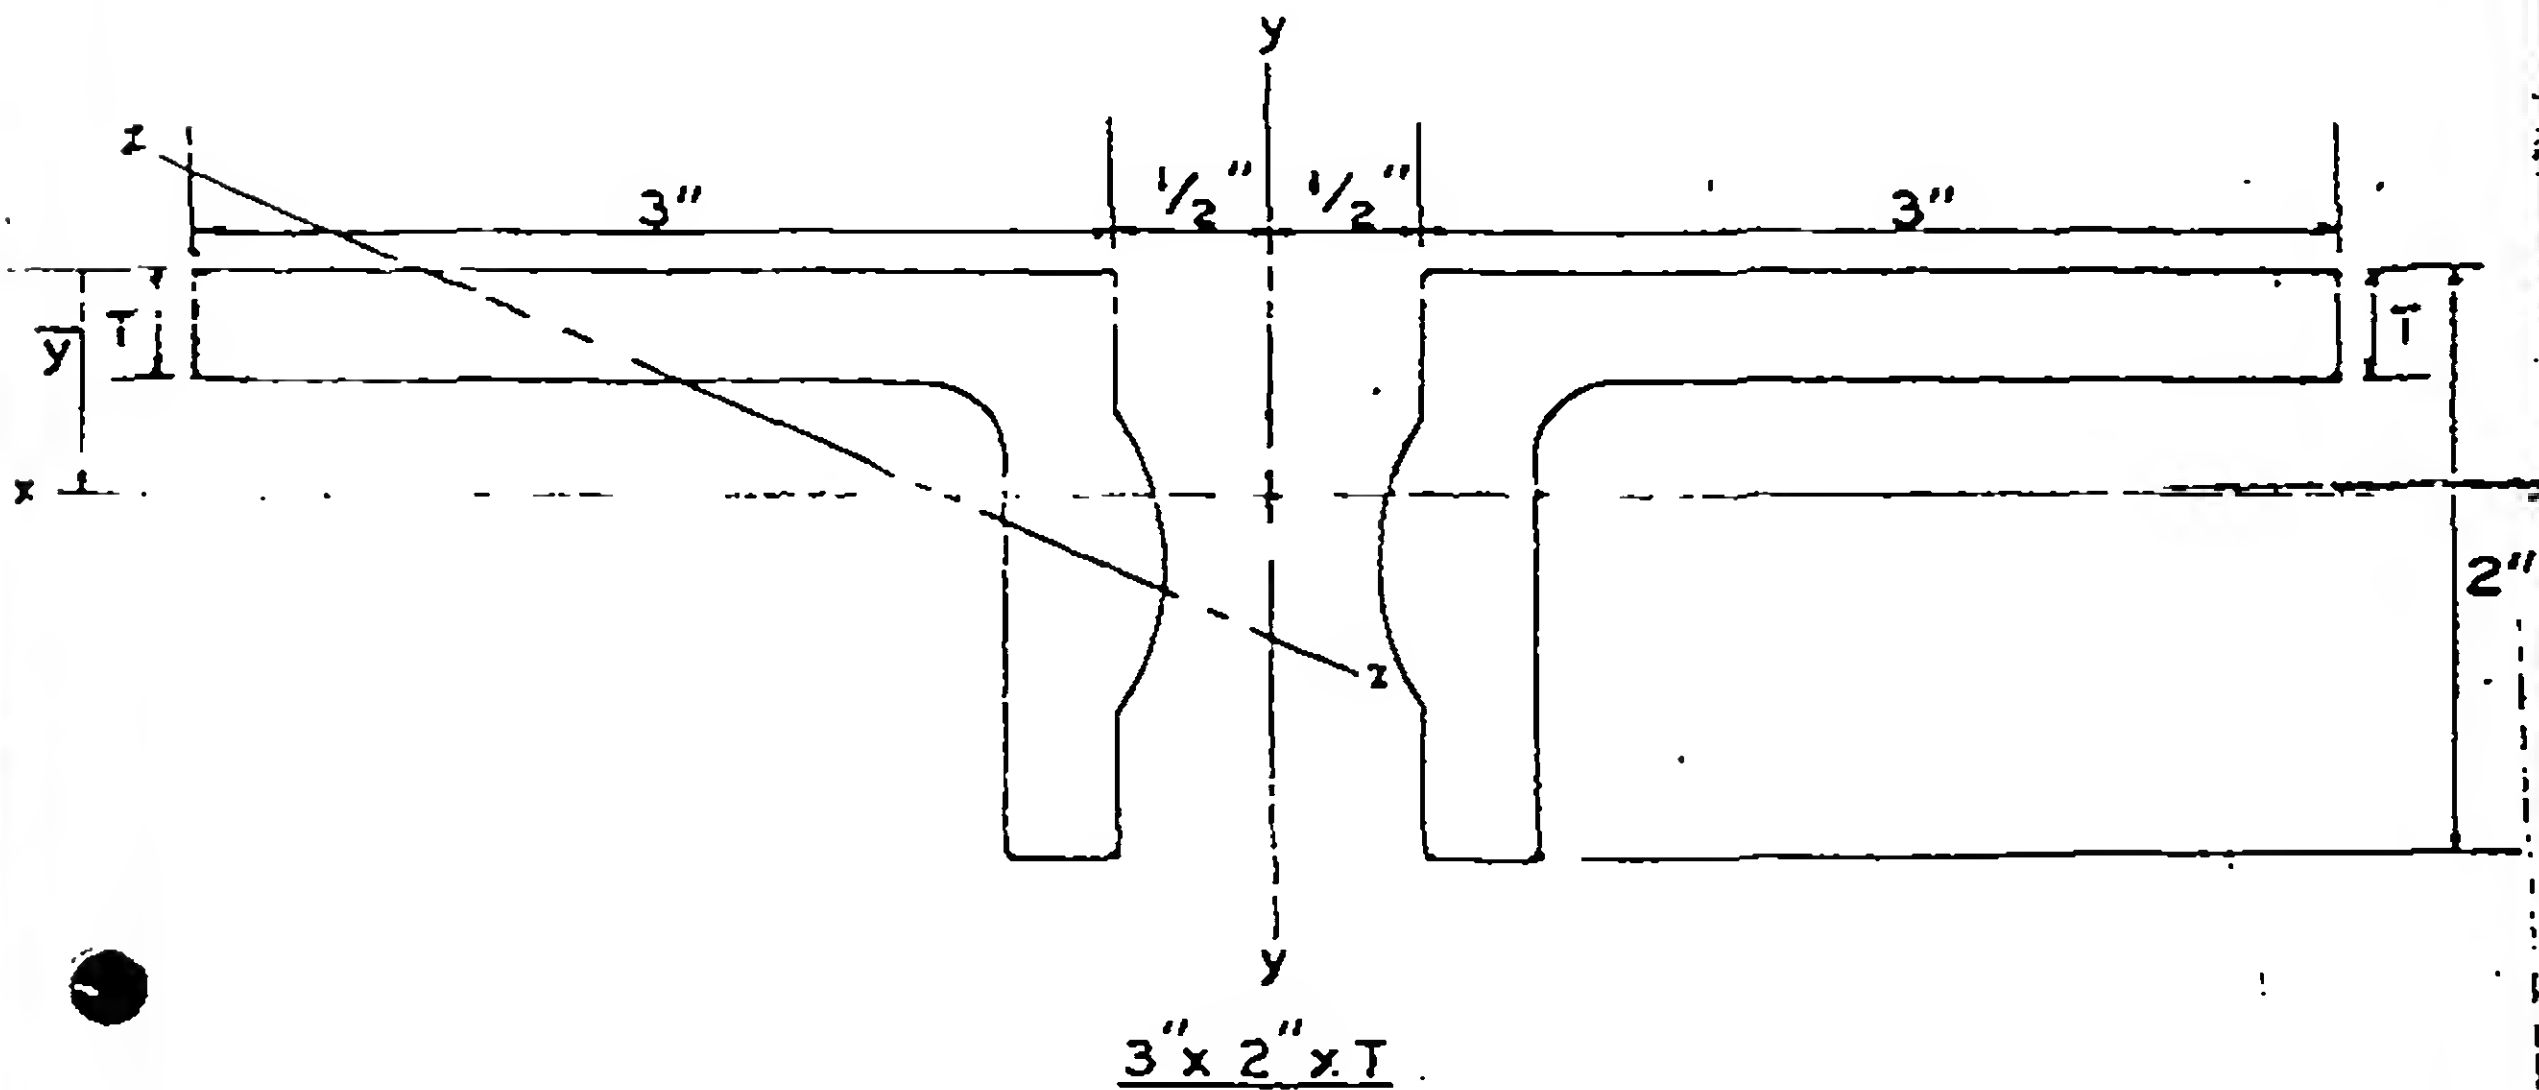

T	1.43 in	1.47 in			
AREA	1.43 in ²	1.47 in ²			1
\bar{y}	1.43 in	1.47 in			
I_x	1.43 in ⁴	1.47 in ⁴			
I_y	1.43 in ⁴	1.47 in ⁴			
r_x	1.47 in	1.47 in			
r_y	1.43 in	1.47 in			
r_z (ONE ANGLE)	1.43 in	1.47 in			
LBS / FT (TWO ANGLES)	11.20	12.43			



LACLEDE STEEL COMPANY SAINT LOUIS, MISSOURI

DRAWING NO. D.10.3


SUBJECT WORLD TRADE CENTER TOWERS

BY L.J.S. DATE 2-6-67

THE PORT OF NEW YORK AUTHORITY

CHKD BY A.C.W. DATE 2-7-67


TRUSS SECTION COMPONENTS
TRUSS WEB SECTIONS
DESIGN SECTION PROPERTIES

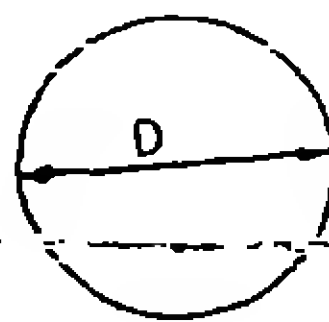

98

99

DIAMETER					0.75 in
AREA		.770			0.44
RAD. OF GYR.					0.1875
LBS / FT					

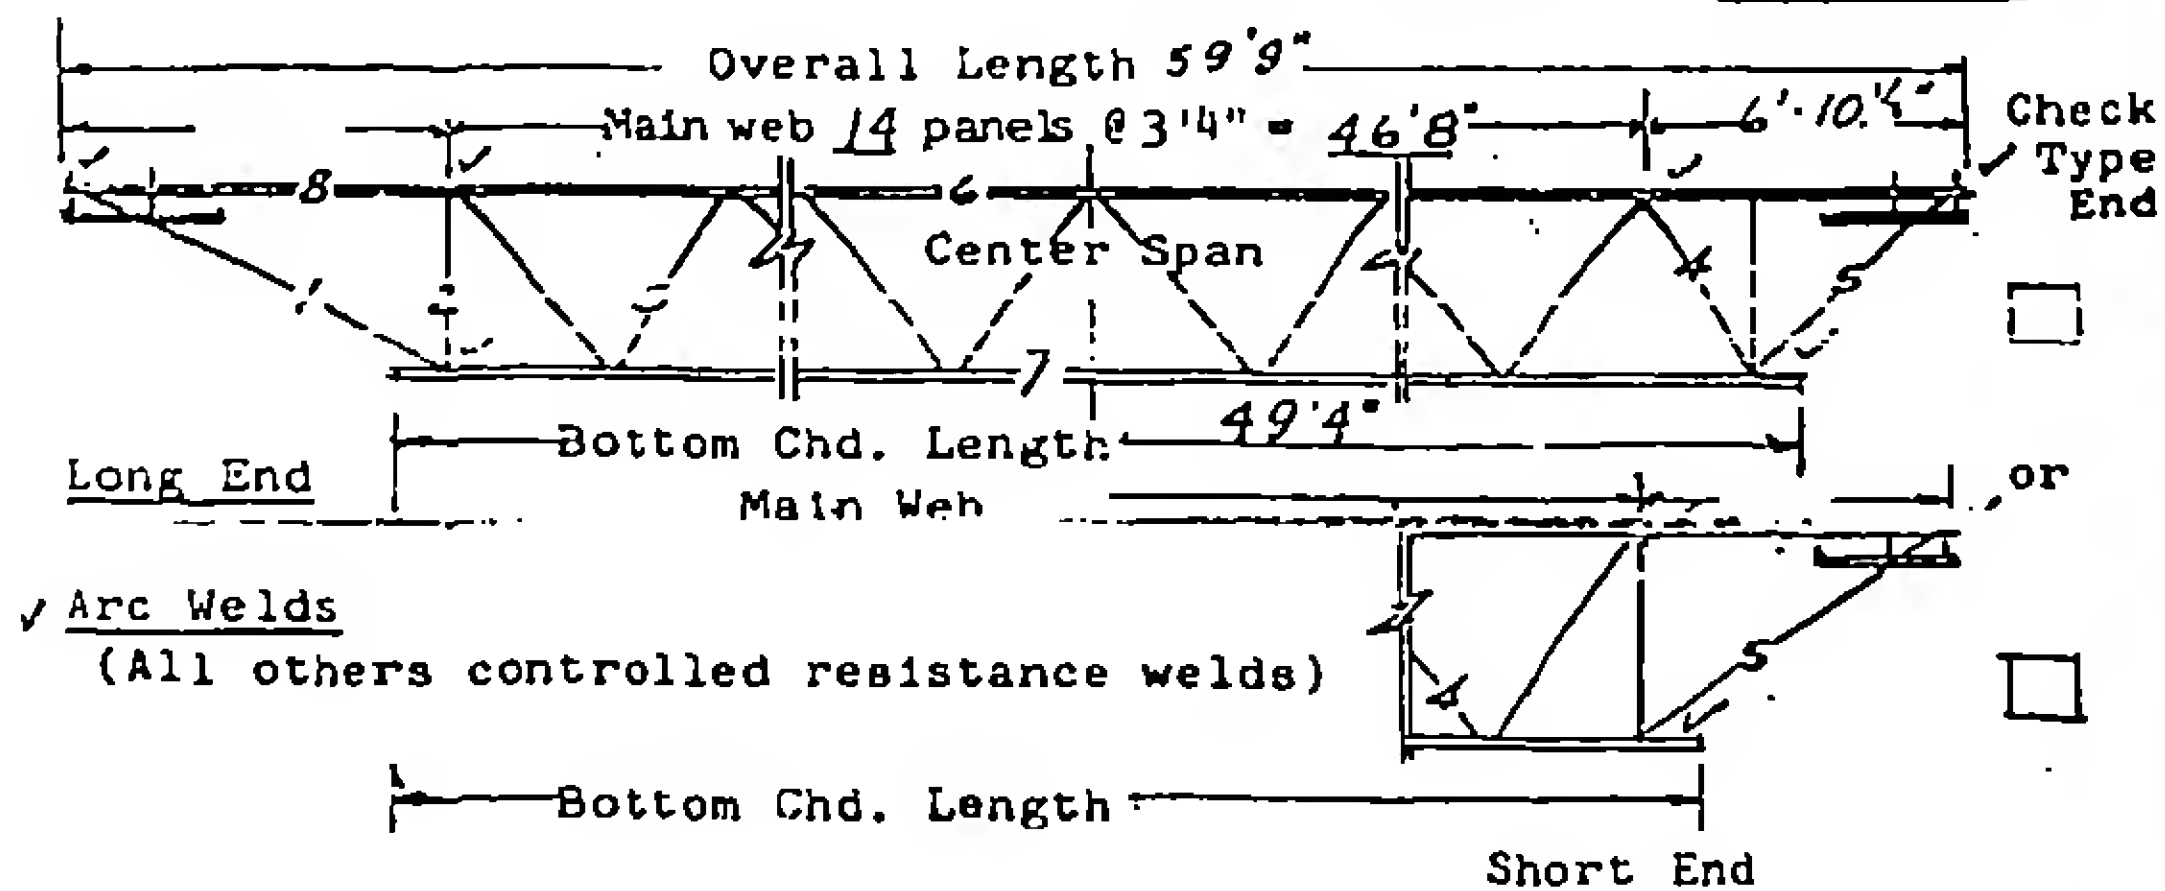WORLD TRADE CENTER
FLOOR GRID TRUSSES
DESIGN DATATruss Mk. 2C32T1-599Truss Component Mk. C32T1-599

NOTES:

Main Web - Continuous uniform section throughout Member Mk. 3.
(Top chord fillers same section as Main Web - at midpoint 10
center web panels minimum.)

Vertical Struts Mk. 2 - Same size as main web.


End Bearing Struts - Same size as main web.

Composite Type - Webs extend above top chord 3".

MEMBERS REQUIRED PER TRUSS COMPONENT S or C ✓

Member	Mk. No.	Grade of Steel	Size	Total Length Member	Weight Member
Top Chord	6-8	A-441	2-2" x 1 1/2" x 0.25"		
Bottom Chord	7	A-36	2-3" x 2" x 0.37"		
Main Web	3	A-36	1.09" DIA.		
Compression Web	4	A-441	1.14" DIA.		
Vertical End Struts	2	A-36	1.09" DIA.		
Long End Diagonal	1	A-441	1.04" DIA.		
Short End Diagonal	5	A-441	1.14" DIA.		

WORLD TRADE CENTER
FLOOR GRID TRUSSES
DESIGN DATA

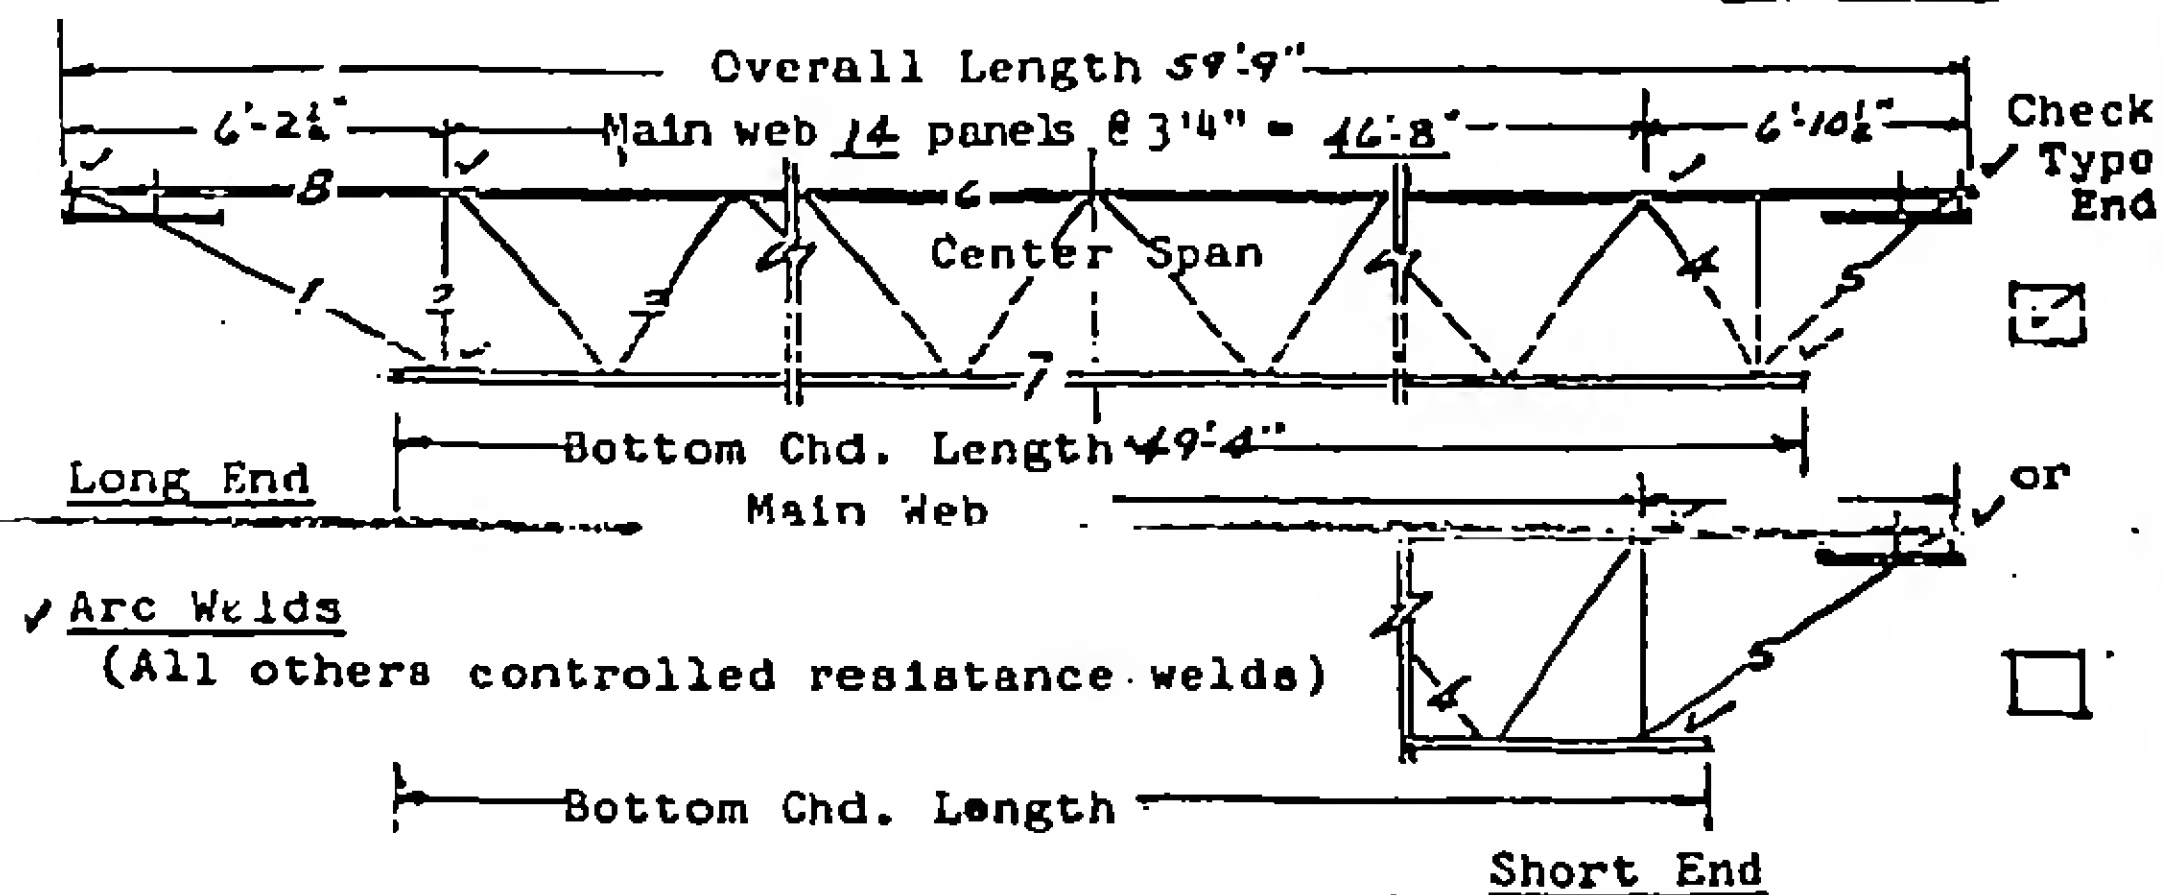Truss Mk. 2C32T1-599Truss Component Mk. C32T1-599NOTES:

Main Web - Continuous uniform section throughout Member Mk. 3.
(Top chord fillers same section as Main Web - at midpoint 10
center web panels minimum.)

Vertical Struts Mk. 2 - Same size as main web.

End Bearing Struts - Same size as main web.

Composite Type - Webs extend above top chord 4".

MEMBERS REQUIRED PER TRUSS COMPONENT S or C ✓

Member	Mk.No.	Grade of Steel	Size	Total Length Member	Weight Member
Top Chord	6-8	A-441	2-2" x 1 1/2" x 0.25"x		
Bottom Chord	7	A-36	2-3" x 2" x 0.375"		
Main Web	3	A-36	1.09" DIA		
Compression Web	4	A-441	1.14" DIA		
Vertical End Struts	2	A-36	1.09" DIA		
Long End Diagonal	1	A-441	1.14" DIA		
Short End Diagonal	5	A-441	1.14" DIA		

LACLEDE STEEL COMPANY

D105- T 1 -Sheet 1A

SPECIAL SECTIONS

(Extended, square ends, etc.)

WORLD TRADE CENTER
FLOOR GRID TRUSSES
DESIGN DATATRUSS UNIT MARKED 2C32T1 Refer to drawings ST 101.6.7.Clearspan "L" = 58.92 ft. Spacing = 6.67 ft.Applicable Total Moment = 4,570,000 inch pounds.Based on 138 lbs./sq. ft. Total Load "W".Applicable End Reaction = 25,500 pounds.Based on 129 lbs./sq. ft. Total Load "W".~~Applicable Total Constr. Moment = 1,740,000 inch pounds.~~Based on 50 lbs./sq. ft. Construction Load.Applicable Constr. End Reaction = 10,000 pounds.Based on 50 lbs./sq. ft. Construction Load."V" Shear at End Panel = 22,940 pounds. ED = 3.00 ft.WEB MEMBER #1 Distance from End Panel = 0.0 ft.Applicable Shear V_x = 22,940 lbs. f_y = 50,000 psiSlope = 2.65 f_s = 30,000 psi l = — in. f_{sc} = — psiReqd. Area = 2.05 sq. in. Use 2-1.14" DIA Area = 2.04 sq. in.WEB MEMBER #2 Distance from End Panel = 0.0 ft.Applicable Shear V_x = 22,940 lbs. f_y = 36,000 psiSlope = 1.00 f_s = — psi l = 25.5 in. f_{sc} = 13,510 psiReqd. Area = 1.69 sq. in. Use 2-1.09" DIA Area = 1.87 sq. in.WEB MEMBER #3 Distance from End Panel = 4.87 ft.Applicable Shear V_x = 18,780 lbs. f_y = 36,000 psiSlope = 1.162 f_s = — psi l = 29.5 in. f_{sc} = 11,820 psiReqd. Area = 1.85 sq. in. Use 2-1.09" DIA Area = 1.87 sq. in.

WEB MEMBER #4 Distance from End Panel = 3.04 ft.
 Applicable Shear $V_x = \underline{20,340}$ lbs. $f_y = \underline{50,000}$ psi
 Slope = 1.162 $f_s = \underline{\quad}$ psi
 $l = \underline{29.5}$ in. $f_{sc} = \underline{13,850}$ psi
 Req'd. Area = 1.71 sq. in. Use 2-1.14" o/a Area = 2.04 sq. in.

WEB MEMBER #5 Distance from End Panel = 0.0 ft.
 Applicable Shear $V_x = \underline{22,940}$ lbs. $f_y = \underline{50,000}$ psi
 Slope = 2.20 $f_s = \underline{30,000}$ psi
 $\phi = \underline{\quad}$
 Req'd. Area = 1.68 sq. in. Use 2-1.14" o/a Area = 2.04 sq. in.

CHORD MEMBER #6 Consists of 4-2"x1 1/2" x 0.25" Angles
 Construction Load Design Area = 5.60 sq. in.
 Applicable Moment = 1,740,000 in. lbs. $f_y = \underline{50,000}$ psi
 $l = \underline{33,375}$ in. $f_s = \underline{\quad}$ psi
 $r_x = \underline{0.44}$ in. $f_{sc} = \underline{19,380}$ psi
 $r_z = \underline{0.31}$ in. (with fillers in middle 60% of span)
 $\frac{l}{r_x} = \underline{10.0}$
 $\frac{l}{2r_z} = \underline{53.8}$ $\frac{f_a}{F_a} + \frac{f_b C_m}{F_b (1 - \frac{f_a}{F_e})} = \underline{0.949}$ less than 1
 $f_a = \underline{17,250}$ psi
 $F_a = \underline{19,380}$ psi
 $f_b = \underline{810}$ psi
 $F_b = \underline{30,000}$ psi
 $F_e = \underline{25,950}$ psi

Use 4-2"x1 1/2" x 0.25" A's Area = 5.60 sq. in.

CHORD MEMBER #7 Consists of 4-3"x2" x 0.37" Angles
 Total Load Design Area = 7.52 sq. in.

CHORD MEMBER #7 (CONTD.)

Applicable Moment = 4,570,000 in lbs. $f_y = \underline{36,000}$ psi $f_s = \underline{22,000}$ psi $f_{sc} = \underline{\quad\quad\quad}$ psi $D_t = \underline{33.00}$ in. $B_{eff} = \underline{64.00}$ in. $t = \underline{4.00}$ in. $y_1 = \underline{2.00}$ in. $d_2 = \underline{5.86}$ in. $y_2 = \underline{4.44}$ in. $d_3 = \underline{22.14}$ in. $y_3 = \underline{54.44}$ in. $c_1 = \underline{10.30}$ in. $d_1 = \underline{8.30}$ in. $c_2 = \underline{22.70}$ in.

$$I_s = \sum [(I_c + A_c d_1^2) + (I_{TCA} + A_{TCA} d_2^2) + I_{BCA} + A_{BCA} d_3^2]$$

$$\bar{y} = \frac{\sum (A_c y_1 + A_{TCA} y_2 + A_{BCA} y_3)}{\sum (A_c + A_{TCA} + A_{BCA})}$$

 $\bar{y} = \underline{10.30}$ in. $I_s = \underline{4917}$ in.⁴ (2C32T1)Resisting Moment = $f_s \times \frac{I_s}{c_2} = \underline{4,770,000}$ in. lbs.Use 4-5" x 2" x 0.3125 angles - 7.32 sq. in.

Composite Design Top Chord Check

Total Load Design

 $f_c = \underline{3,000}$ psiApplicable Moment = 4,570,000 in. lbs. $f'_c = \underline{1,350}$ psi


$$f'_{cc} = \frac{M C_1}{15 I_s} = \underline{640}$$
 psi

CHORD MEMBER #8

Consists of 4-2" x 1 1/2" x 0.25" AnglesArea = 3.60 sq. in.

(SAME AS MEMBER 6)

WORLD TRADE CENTER
FLOOR GRID TRUSSES
DESIGN DATA

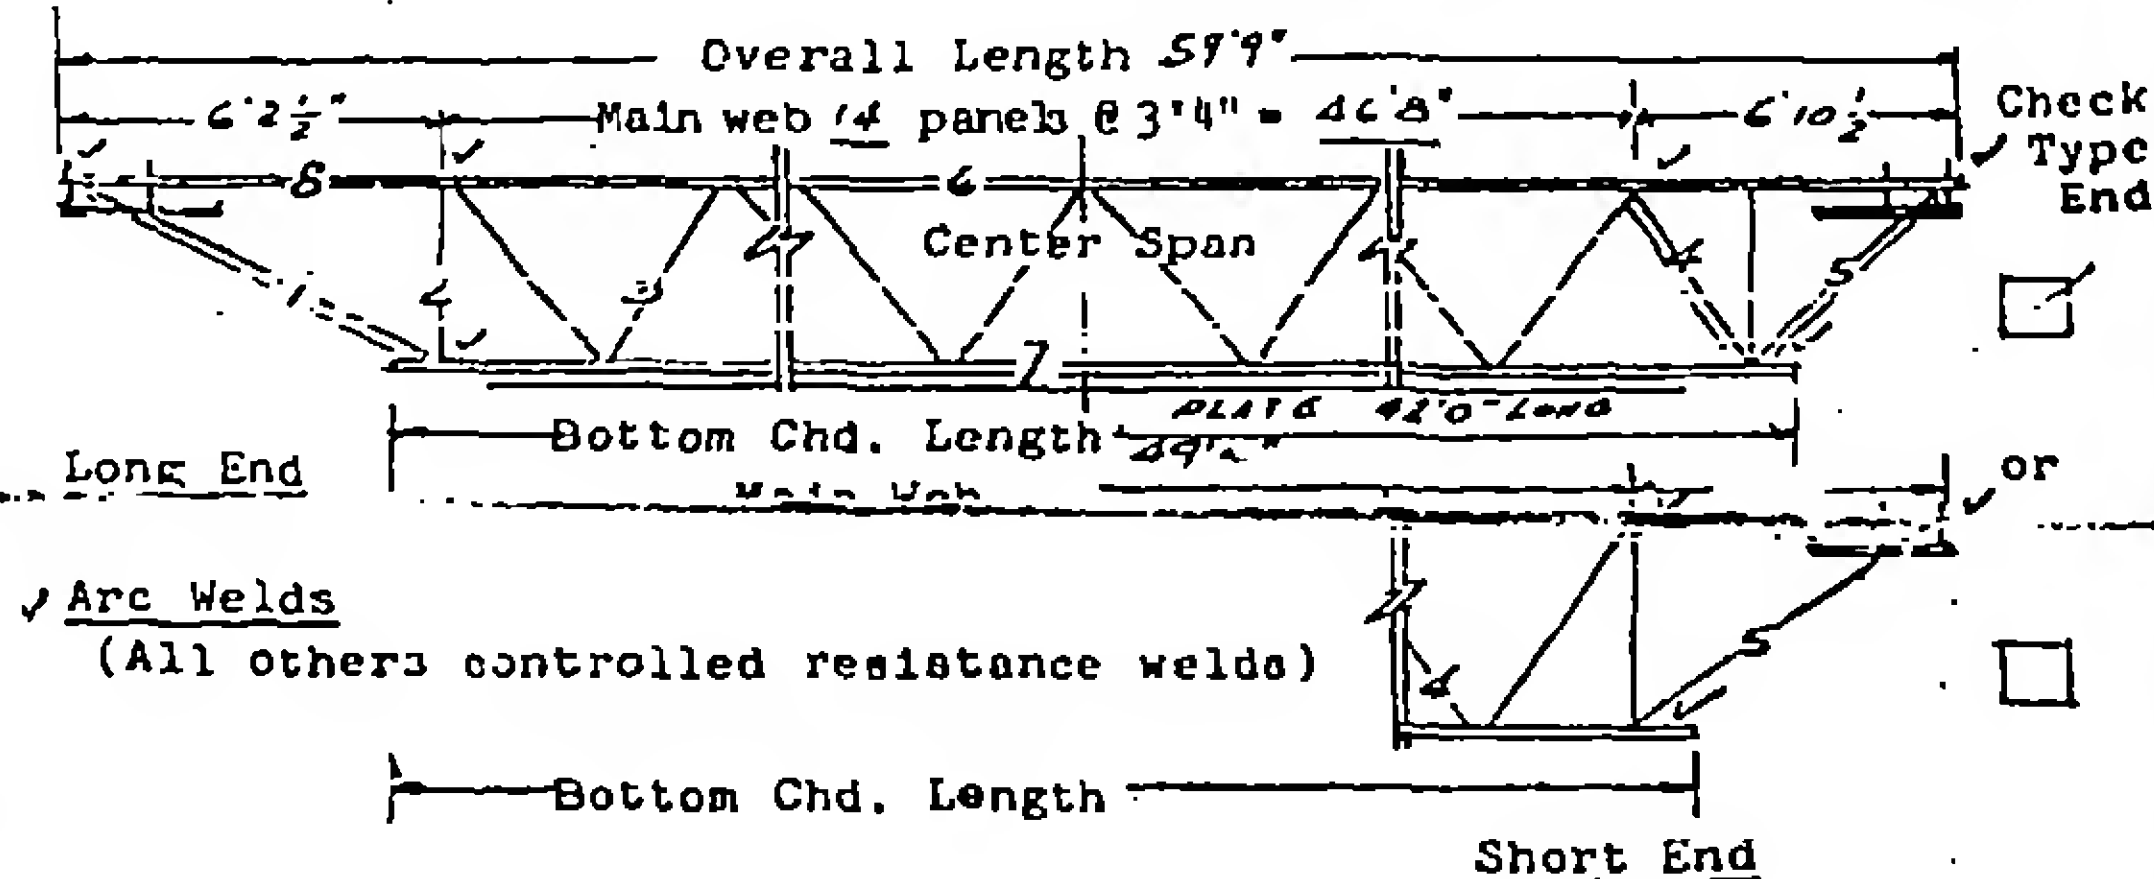Truss Mk. 2 C32T2-599Truss Component Mk. C32T2-599

NOTES:

Main Web - Continuous uniform section throughout Member Mk. 3.
(Top chord fillers same section as Main Web - at midpoint 10
center web panels minimum.)

Vertical Struts Mk. 2 - Same size as main web.

End Bearing Struts - Same size as main web.

Composite Type - Webs extend above top chord 5".

MEMBERS REQUIRED PER TRUSS COMPONENT S or C ✓

Member	Mk.No.	Grade of Steel	Size	Total Length Member	Weight Member
Top Chord	6-8	A 441	2x 2x 1/2 x 31"	59'9"	
Bottom Chord	7	36	2x 2x 1/2 x 31"	49'4"	
Main Web	3	441	1.14" D	86'4"	
Compression Web	4	441	1.14" D + .75" D	3'1" 3'0"	
Vertical End Struts	2	441	1.14" D	2'7 1/2" 2'3 1/2"	
Long End Diagonal	1	441	1.14" D + .75" D	6'6" 6'4"	
Short End Diagonal	5	441	1.14" D + .75" D	5'8" 5'6"	
Bottom Chord Plate		A 36	3/16 x 1'3"	42'0"	

WORLD TRADE CENTER
FLOOR GRID TRUSSES
DESIGN DATATRUSS UNIT MARKED 2C32T2 Refer to drawings ST 101.246.7Clearspan "L" = 59.08 ft. Spacing = 6.67 ft.Applicable Total Moment = 5,630,000 inch pounds.Based on 157 lbs./sq. ft. Total Load "w".Applicable End Reaction = 31,300 pounds.Based on 157 lbs./sq. ft. Total Load "w".Applicable Total Constr. Moment = 1,862,000 inch pounds.Based on 52 lbs./sq. ft. Construction Load.Applicable Constr. End Reaction = 10,360 pounds.Based on 52 lbs./sq. ft. Construction Load."V" Shear at End Panel = 28,150 pounds. ED = 3.0 ft.WEB MEMBER #1 Distance from End Panel = 0.0 ft.Applicable Shear V_x = 28,150 lbs. f_y = 50,000 psiSlope = 2.65 f_b = 30,000 psi l = — in. f_{sc} = — psiReqd. Area = 2.77 sq. in. Use 2-1.17" DIA. Area = 2.92 sq. in.
+ 2-0.75" DIA.WEB MEMBER #2 Distance from End Panel = 0.0 ft.Applicable Shear V_x = 28,150 lbs. f_y = 50,000 psiSlope = 1.00 f_b = — psi l = 26.0 in. f_{sc} = 16,530 psiReqd. Area = 1.84 sq. in. Use 2-1.14" DIA. Area = 2.04 sq. in.WEB MEMBER #3 Distance from End Panel = 4.87 ft.Applicable Shear V_x = 23,050 lbs. f_y = 50,000 psiSlope = 1.162 f_b = — psi l = 30.0 in. f_{sc} = 13,490 psiReqd. Area = 1.99 sq. in. Use 2-1.14" DIA. Area = 2.04 sq. in.

WEB MEMBER #4

Distance from End Panel = 3.04 ft.Applicable Shear $V_x = \underline{24,950}$ lbs. $f_y = \underline{50,000}$ psiSlope = 1.162 $f_b = \underline{\quad}$ psi $l = \underline{30.0}$ in. $f_{sc} = \underline{13,490}$ psiReqd. Area = 2.15 sq. in. Use 2-1.14" DIA. Area = 2.92 sq. in.
+ 2-0.75" DIA.

WEB MEMBER #5

Distance from End Panel = 0.0 ft.Applicable Shear $V_x = \underline{28,150}$ lbs. $f_y = \underline{50,000}$ psiSlope = 2.20 $f_b = \underline{30,000}$ psi $l = \underline{\quad}$ in.Reqd. Area = 2.06 sq. in. Use 2-1.14" DIA. Area = 2.92 sq. in.
+ 2-0.76" DIA.

CHORD MEMBER #6

Consists of 4-2"x1 1/2"x0.31" Angles

Construction Load Design

Area = 4.30 sq. in.Applicable Moment = 1,860,000 in. lbs. $f_y = \underline{50,000}$ psi $l = \underline{33.375}$ in. $f_b = \underline{\quad}$ psi $r_x = \underline{0.43}$ in. $f_{sc} = \underline{19,080}$ psi $r_z = \underline{0.31}$ in. (with fillers in middle 60% of span) $\frac{l}{r_x} = \underline{77.6}$

$$\frac{l}{2r_z} = \underline{53.8} \quad \frac{f_a}{F_a} + \frac{f_b C_m}{F_b (1 - \frac{f_a}{F'_e})} = \underline{0.859} \text{ less than } 1$$

 $f_a = \underline{15,400}$ psi $F_a = \underline{19,080}$ psi $f_b = \underline{770}$ psi $F_b = \underline{30,000}$ psi $F'_e = \underline{24,770}$ psiUse 4-2"x1 1/2"x0.31" &'s Area = 4.30 sq. in.

CHORD MEMBER #7

Consists of 4-2"x1 1/2"x0.31"&'s + 15"x5/16" R Angles

Total Load Design

Area = 8.99 sq. in.
(4.69 + 4.30)

CHORD MEMBER #7 (CONTD.)

Applicable Moment = 5,630,000 in lbs. $f_y = \underline{36,000}$ psi $D_t = \underline{33.31}$ in. $f_s = \underline{22,000}$ psi $B_{eff} = \underline{67.00}$ in. $f_{sc} = \underline{\quad}$ psi $t = \underline{1.00}$ in. $y_4 = \underline{33.16}$ in. $d_4 = \underline{21.67}$ in. $y_1 = \underline{2.00}$ in. $d_2 = \underline{7.03}$ in. $y_2 = \underline{4.46}$ in. $d_3 = \underline{21.05}$ in. $y_3 = \underline{32.54}$ in. $c_1 = \underline{11.49}$ in. $d_1 = \underline{9.49}$ in. $c_2 = \underline{21.82}$ in.

$$I_s = \sum [(I_c + A_c d_1^2) + (I_{TCA} + A_{TCA} d_2^2) + I_{BCA} + A_{BCA} d_3^2]$$

$$\bar{y} = \frac{\sum (A_c y_1 + A_{TCA} y_2 + A_{BCA} y_3)}{\sum (A_c + A_{TCA} + A_{BCA})}$$

 $\bar{y} = \underline{11.49}$ in. $I_s = \underline{5,877}$ in.⁴ (2 C32T2 + PLATE)Resisting Moment = $f_s \times \frac{I_s}{c_2} = \underline{5,920,000}$ in. lbs.Net Area = 5.94 sq. in.

Composite Design Top Chord Check

Total Load Design

 $f_c = \underline{3,000}$ psiApplicable Moment = 5,630,000 in. lbs. $f'_c = \underline{1,350}$ psi

$$f'_{cc} = \frac{M_{cl}}{15 I_s} = \underline{733}$$
 psi

CHORD MEMBER #8

Consists of 4 - 2" x 1 1/2" x 0.31" AnglesArea = 4.30 sq. in.

(SAME AS MEMBER 6)

CHORD MEMBER #7 (CONTD.)

Applicable Moment = _____ in lbs. $f_y = 36,000$ psi $D_t = 33.00$ in. $f_s = 22,000$ psi $B_{eff} = 64.00$ in. $f_{sc} =$ _____ psi $t = 4.00$ in.

WITHOUT COVER PLATE

 $y_1 = 2.00$ in. $d_2 = 3.08$ in. $y_2 = 4.46$ in. $c_3 = 25.00$ in. $y_3 = 32.54$ in. $c_1 = 7.54$ in. $d_1 = 5.54$ in. $c_2 = 25.46$ in.

$$I_s = \sum [(I_c + A_c d_1^2) + (I_{TCA} + A_{TCA} d_2^2) + I_{BCA} + A_{BCA} d_3^2]$$

$$\bar{y} = \frac{\sum (A_c y_1 + A_{TCA} y_2 + A_{BCA} y_3)}{\sum (A_c + A_{TCA} + A_{BCA})}$$

 $\bar{y} = 7.54$ in. $I_s = 3,275$ in.⁴ C32T2Resisting Moment = $f_s \times \frac{I_s}{c_2} = 2,830,000$ in. lbs.Use 4-2x12 0.31 4's Area = 4.30 sq. in.

Composite Design Top Chord Check

Total Load Design

 $f_c =$ _____ psi

Applicable Moment = _____ in. lbs.

 $f'_c =$ _____ psi

$$f'_{cc} = \frac{M_{cl}}{15I_s} =$$
 _____ psi


CHORD MEMBER #8

Consists of _____ Angles

Area = _____ sq. in.

(SAME AS MEMBER 6)

WORLD TRADE CENTER
FLOOR GRID TRUSSES
DESIGN DATA

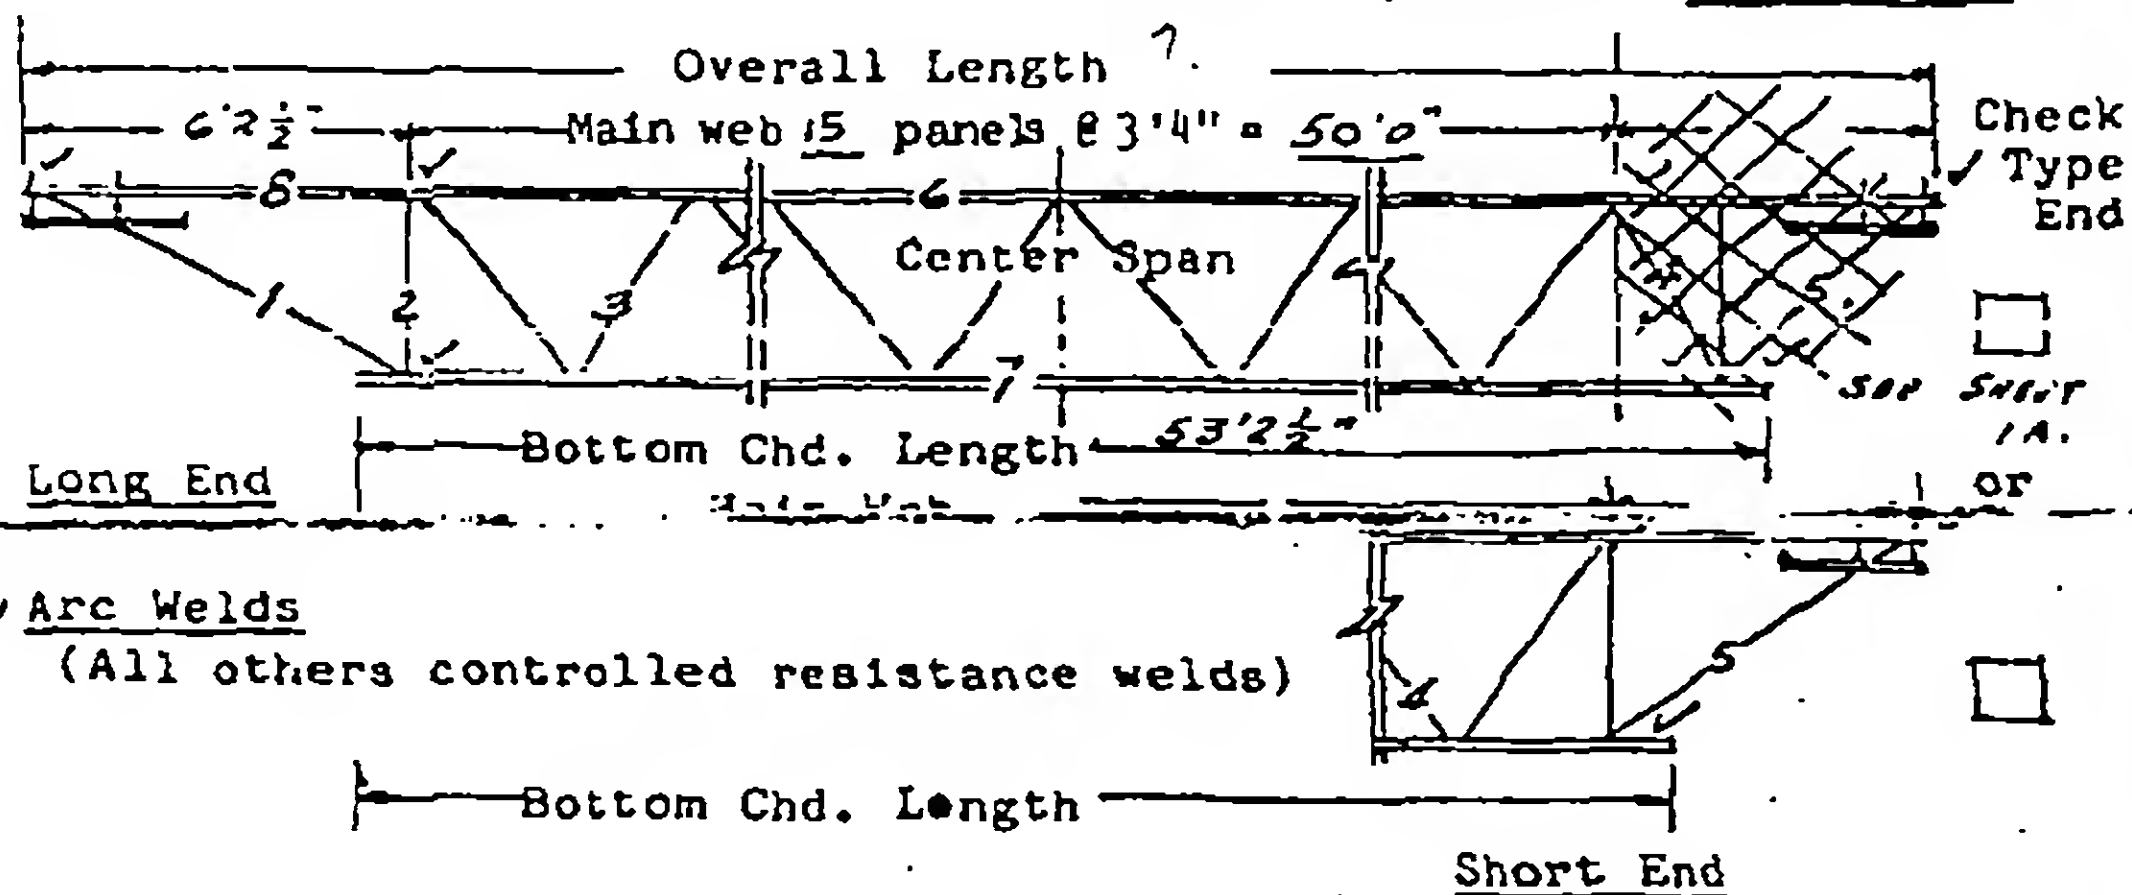Truss Mk. 2C32T3-5811Truss Component Mk. C32T3-5811

NOTES:

Main Web - Continuous uniform section throughout Member Mk. 3.
(Top chord fillers same section as Main Web - at midpoint center web panels minimum.)

Vertical Struts Mk. 2 - Same size as main web.

End Bearing Struts - Same size as main web.


Composite Type - Webs extend above top chord 3".

MEMBERS REQUIRED PER TRUSS COMPONENT S or C ✓

Member	Mk.No.	Grade of Steel	Size	Total Length Member	Weight Member
Top Chord	6-8	A 441	2L3 2x1 1/2 x .25	58'9"	
Bottom Chord	7	36	2L3 3x2 x .33	53'2 1/2"	
Main Web	3	36	1.09'D	9'6"	
Compression Web	4	441	1.14'D	3'1"	
Vertical End Struts	2	36	1.09'D	2x27' 1/2 2x33 1/2"	
Long End Diagonal	1	441	1.14'D	6'6"	
Short End Diagonal	5	441	1.14'D	2'6"	
Top Chd ATT. PLATE		A 36	3/8 x 5" (1/2 / Truss)	9"	
Bot Chord ATT. L ^e		36	2L3 2x1 1/2 x .25	1'3"	
" " L ^e		36	2L3	6"	

SPECIAL SECTIONS

(Extended, square ends, etc.)

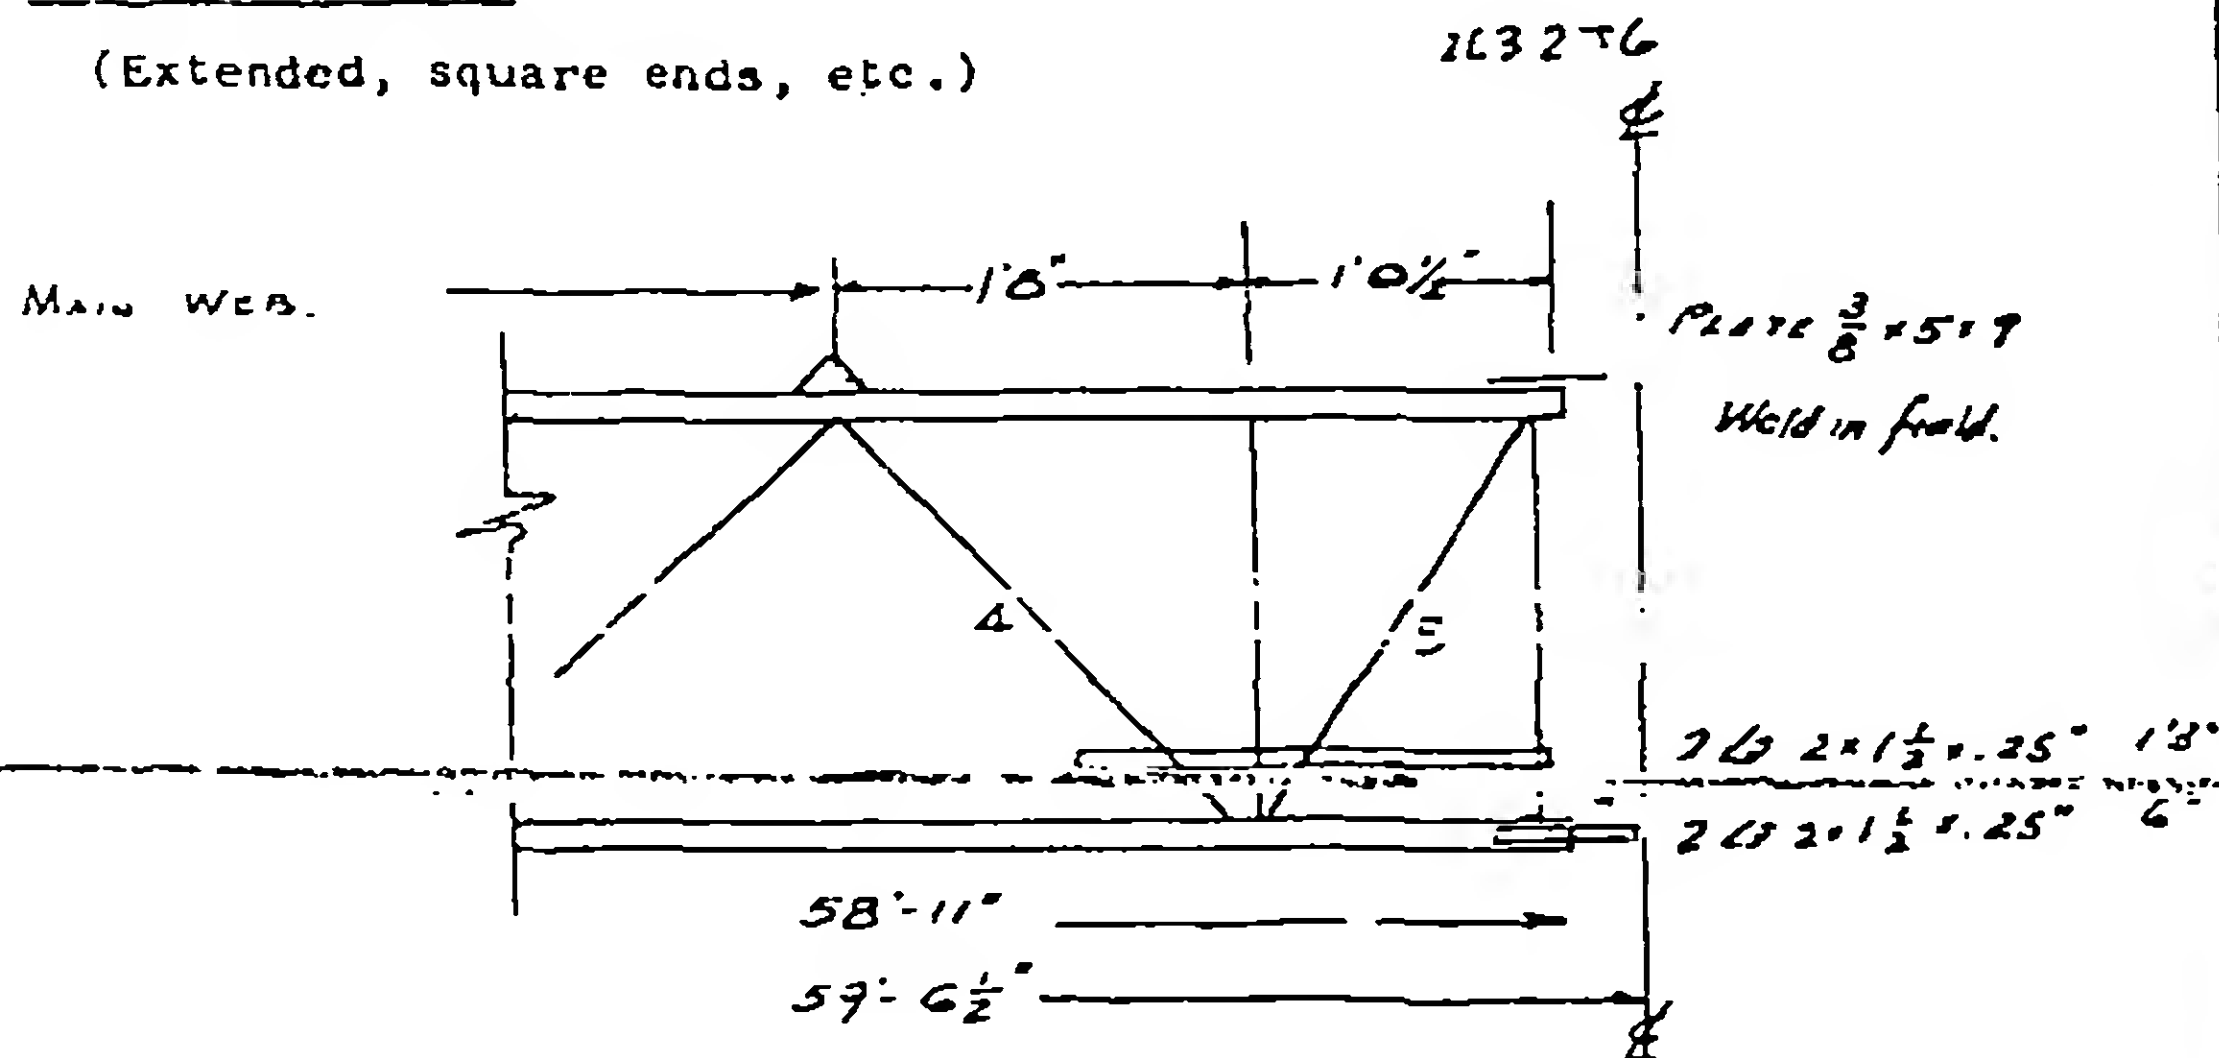

$$R = \frac{(6.67)(.121)(59.24)}{2} = 24.00 K$$

$$V_s = 24.0 - \frac{14}{12} (.121)(6.67) = 23.06 K$$

$$V_c = V_s - \frac{16}{12} (.121)(6.67) = 21.98 K$$

WORLD TRADE CENTER
FLOOR GRID TRUSSES
DESIGN DATATRUSS UNIT MARKED 2C32T3 Refer to drawings ST 10, 2, 4, 6, 7.Clearspan "L" = 59.08 ft. Spacing = 6.67 ft.Applicable Total Moment = 4,275,000 inch pounds.Based on 121 lbs./sq. ft. Total Load "w".Applicable End Reaction = 24,000 pounds.Based on 121 lbs./sq. ft. Total Load "w".~~Applicable Total Moment = 1,915,000 inch pounds.~~Based on 52 lbs./sq. ft. Construction Load.Applicable Constr. End Reaction = 10,300 pounds.Based on 52 lbs./sq. ft. Construction Load."V" Shear at End Panel = 21,580 pounds. ED = 3.0 ft.WEB MEMBER #1 Distance from End Panel = 0.0 ft.Applicable Shear V_x = 21,580 lbs. f_y = 50,000 psiSlope = 2.65 f_s = 30,000 psi l = — in. f_{bc} = — psiReqd. Area = 1.91 sq. in. Use 2-1.14" DIA. Area = 2.04 sq. in.WEB MEMBER #2 Distance from End Panel = 0.0 ft.Applicable Shear V_x = 21,580 lbs. f_y = 36,000 psiSlope = 1.00 f_s = — psi l = 25.5 in. f_{sc} = 13,510 psiReqd. Area = 1.59 sq. in. Use 2-1.09" DIA. Area = 1.87 sq. in.WEB MEMBER #3 Distance from End Panel = 4.87 ft.Applicable Shear V_x = 17,650 lbs. f_y = 36,000 psiSlope = 1.162 f_s = — psi l = 29.5 in. f_{sc} = 11,820 psiReqd. Area = 1.73 sq. in. Use 2-1.09" DIA. Area = 1.87 sq. in.

WEB MEMBER #4 Distance from End Panel = 2.50 ft. (ED = 0)
 Applicable Shear $V_x = \underline{21,980}$ lbs. $f_y = \underline{50,000}$ psi
 Slope = 1.162 $f_s = \underline{\quad}$ psi
 $l = \underline{29.5}$ in. $f_{sc} = \underline{13,580}$ psi
 Req'd. Area = 1.88 sq. in. Use 2-1.14" DIA. Area = 2.04 sq. in.

WEB MEMBER #5 Distance from End Panel = 1.17 ft. (ED = 0)
 Applicable Shear $V_x = \underline{23,060}$ lbs. $f_y = \underline{50,000}$ psi
 Slope = 1.06 $f_s = \underline{30,000}$ psi
 $l = \underline{\quad}$ in. $f_{sc} = \underline{\quad}$ psi
 Req'd. Area = 0.815 sq. in. Use 2-1.14" DIA. Area = 2.04 sq. in.

CHORD MEMBER #6 Consists of 4-2" x 1 1/2" x 0.25" Angles
 Construction Load Design Area = 3.60 sq. in.
 Applicable Moment = 1,815,000 in. lbs. $f_y = \underline{50,000}$ psi
 $l = \underline{33,375}$ in. $f_s = \underline{\quad}$ psi
 $r_x = \underline{0.44}$ in. $f_{sc} = \underline{19,380}$ psi
 $r_z = \underline{0.31}$ in. (with fillers in middle 60% of span)

$\frac{l}{r_x} = \underline{75.8}$
 $\frac{l}{2r_z} = \underline{53.8}$

$$\frac{f_a}{F_a} + \frac{f_b C_m}{F_b (1 - \frac{f_a}{F_e})} = \underline{0.995}$$
 less than 1
 $f_a = \underline{18,000}$ psi
 $F_a = \underline{19,380}$ psi
 $f_b = \underline{843}$ psi
 $F_b = \underline{30,000}$ psi
 $F_e = \underline{25,950}$ psi

Use 4-2" x 1 1/2" x 0.25" x 1/2" Area = 3.60 sq. in.

CHORD MEMBER #7 Consists of 4-3" x 2" x 0.33" Angles
 Total Load Design Area = 6.62 sq. in.

CHORD MEMBER #7 (CONTD.)

Applicable Moment = 4,275,000 in lbs. $f_y = \underline{36,000}$ psi $D_t = \underline{33.00}$ in. $f_b = \underline{22,000}$ psi $B_{eff} = \underline{64.00}$ in. $f_{sc} = \underline{\hspace{1cm}}$ psi $t = \underline{4.00}$ in. $y_1 = \underline{2.00}$ in. $d_2 = \underline{5.25}$ in. $y_2 = \underline{4.44}$ in. $d_3 = \underline{22.76}$ in. $y_3 = \underline{23.15}$ in. $c_1 = \underline{7.67}$ in. $d_1 = \underline{7.69}$ in. $c_2 = \underline{23.31}$ in.

$$I_s = \sum [I_c + A_c d_1^2] + (I_{TCA} + A_{TCA} d_2^2) + I_{BCA} + A_{BCA} d_3^2$$

$$\bar{y} = \frac{\sum (A_c y_1 + A_{TCA} y_2 + A_{BCA} y_3)}{\sum (A_c + A_{TCA} + A_{BCA})}$$

 $\bar{y} = \underline{9.69}$ in. $I_s = \underline{4560}$ in.⁴ (2C32T3)Resisting Moment = $f_c \cdot y \cdot S$
 c_2 $= \underline{1,312,000}$ in. lbs.Use 4 - 3" x 2" x 0.33" 4's Area = 6.62 sq. in.

Composite Design Top Chord Check

Total Load Design

 $f_c = \underline{3,000}$ psiApplicable Moment = 4,275,000 in. lbs. $f'_c = \underline{1,350}$ psi


$$f'_{cc} = \frac{M_{CL}}{15 I_s} = \underline{605}$$
 psi

CHORD MEMBER #8

Consists of 4 - 2" x 1 1/2" x 0.25" AnglesArea = 3.60 sq. in.

(SAME AS MEMBER 6)

WORLD TRADE CENTER
FLOOR GRID TRUSSES
DESIGN DATA

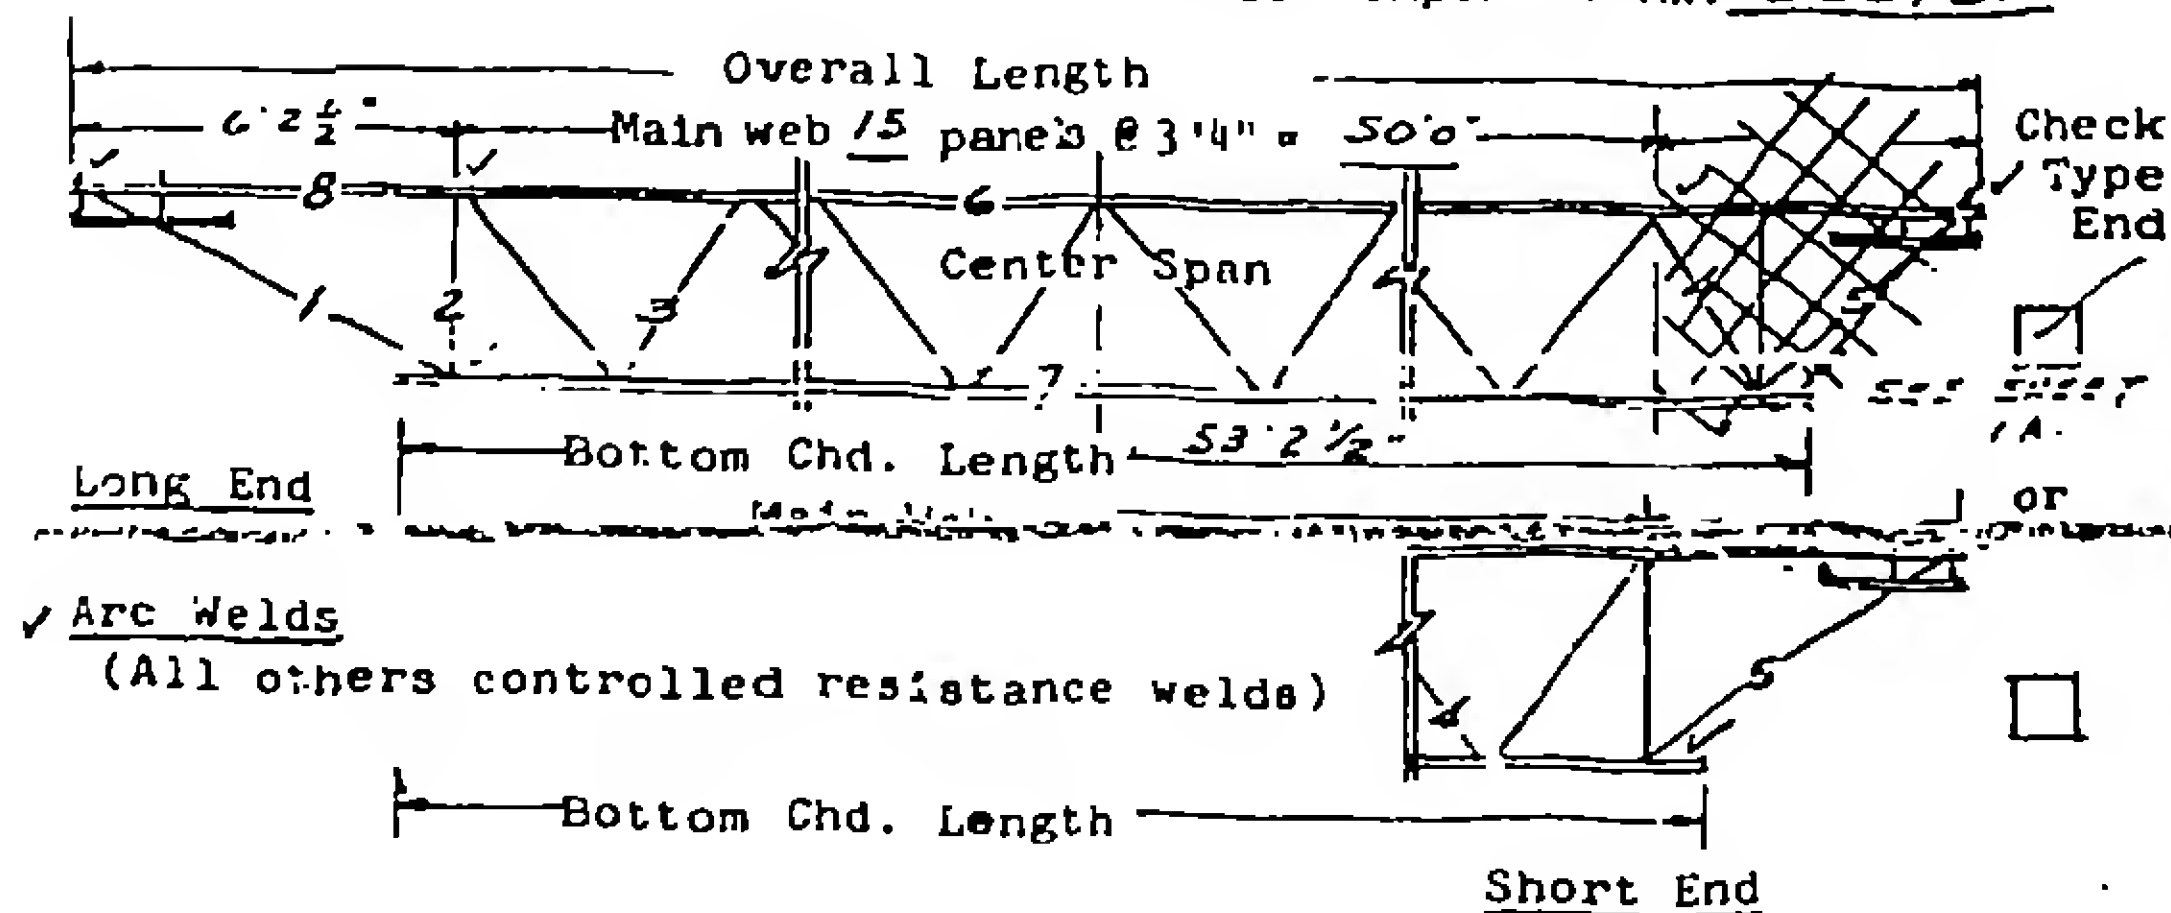Truss Mk. 2 C 32734 - 5B11Truss Component Mk. C 32734

NOTES:

Main Web - Continuous uniform section throughout Member Mk. 3.
(Top chord fillers same section as Main Web - at midpoint 10
center web panels minimum.)

Vertical Struts Mk. 2 - Same size as main web.

End Bearing Struts - Same size as main web.


Composite Type - Webs extend above top chord 3 ".

MEMBERS REQUIRED PER TRUSS COMPONENT S or C ✓

Member	Mk. No.	Grade of Steel	Size	Total Length Member	Weight Member
Top Chord	6-8	A 441	2LS 2 x 1 1/2 x .25	58'11"	
Bottom Chord	7	36	2LS 2 x 1 1/2 x .25	53'2 1/2"	
Main Web	3	36	.92"D	91'6"	
Compression Web	4	441	.98"D	3'1"	
Vertical End Struts	2	36	.92"D	2 x 27 1/2 x 2 x 3 1/2"	
Long End Diagonal	1	441	.98"D	6'6"	
Short End Diagonal	5	441	.98"D	2'6"	
Top Chd. ATT PLATE		A 36	3/8 x 5 (1/2/TRUSS)	9"	
Bottom Chd ATT L		36	2LS 2 x 1 1/2 x .25	1'3"	
Bottom Chd ATT L		36	2LS 2 x 1 1/2 x .25	6"	

SPECIAL SECTIONS

(Extended, square ends, etc.)

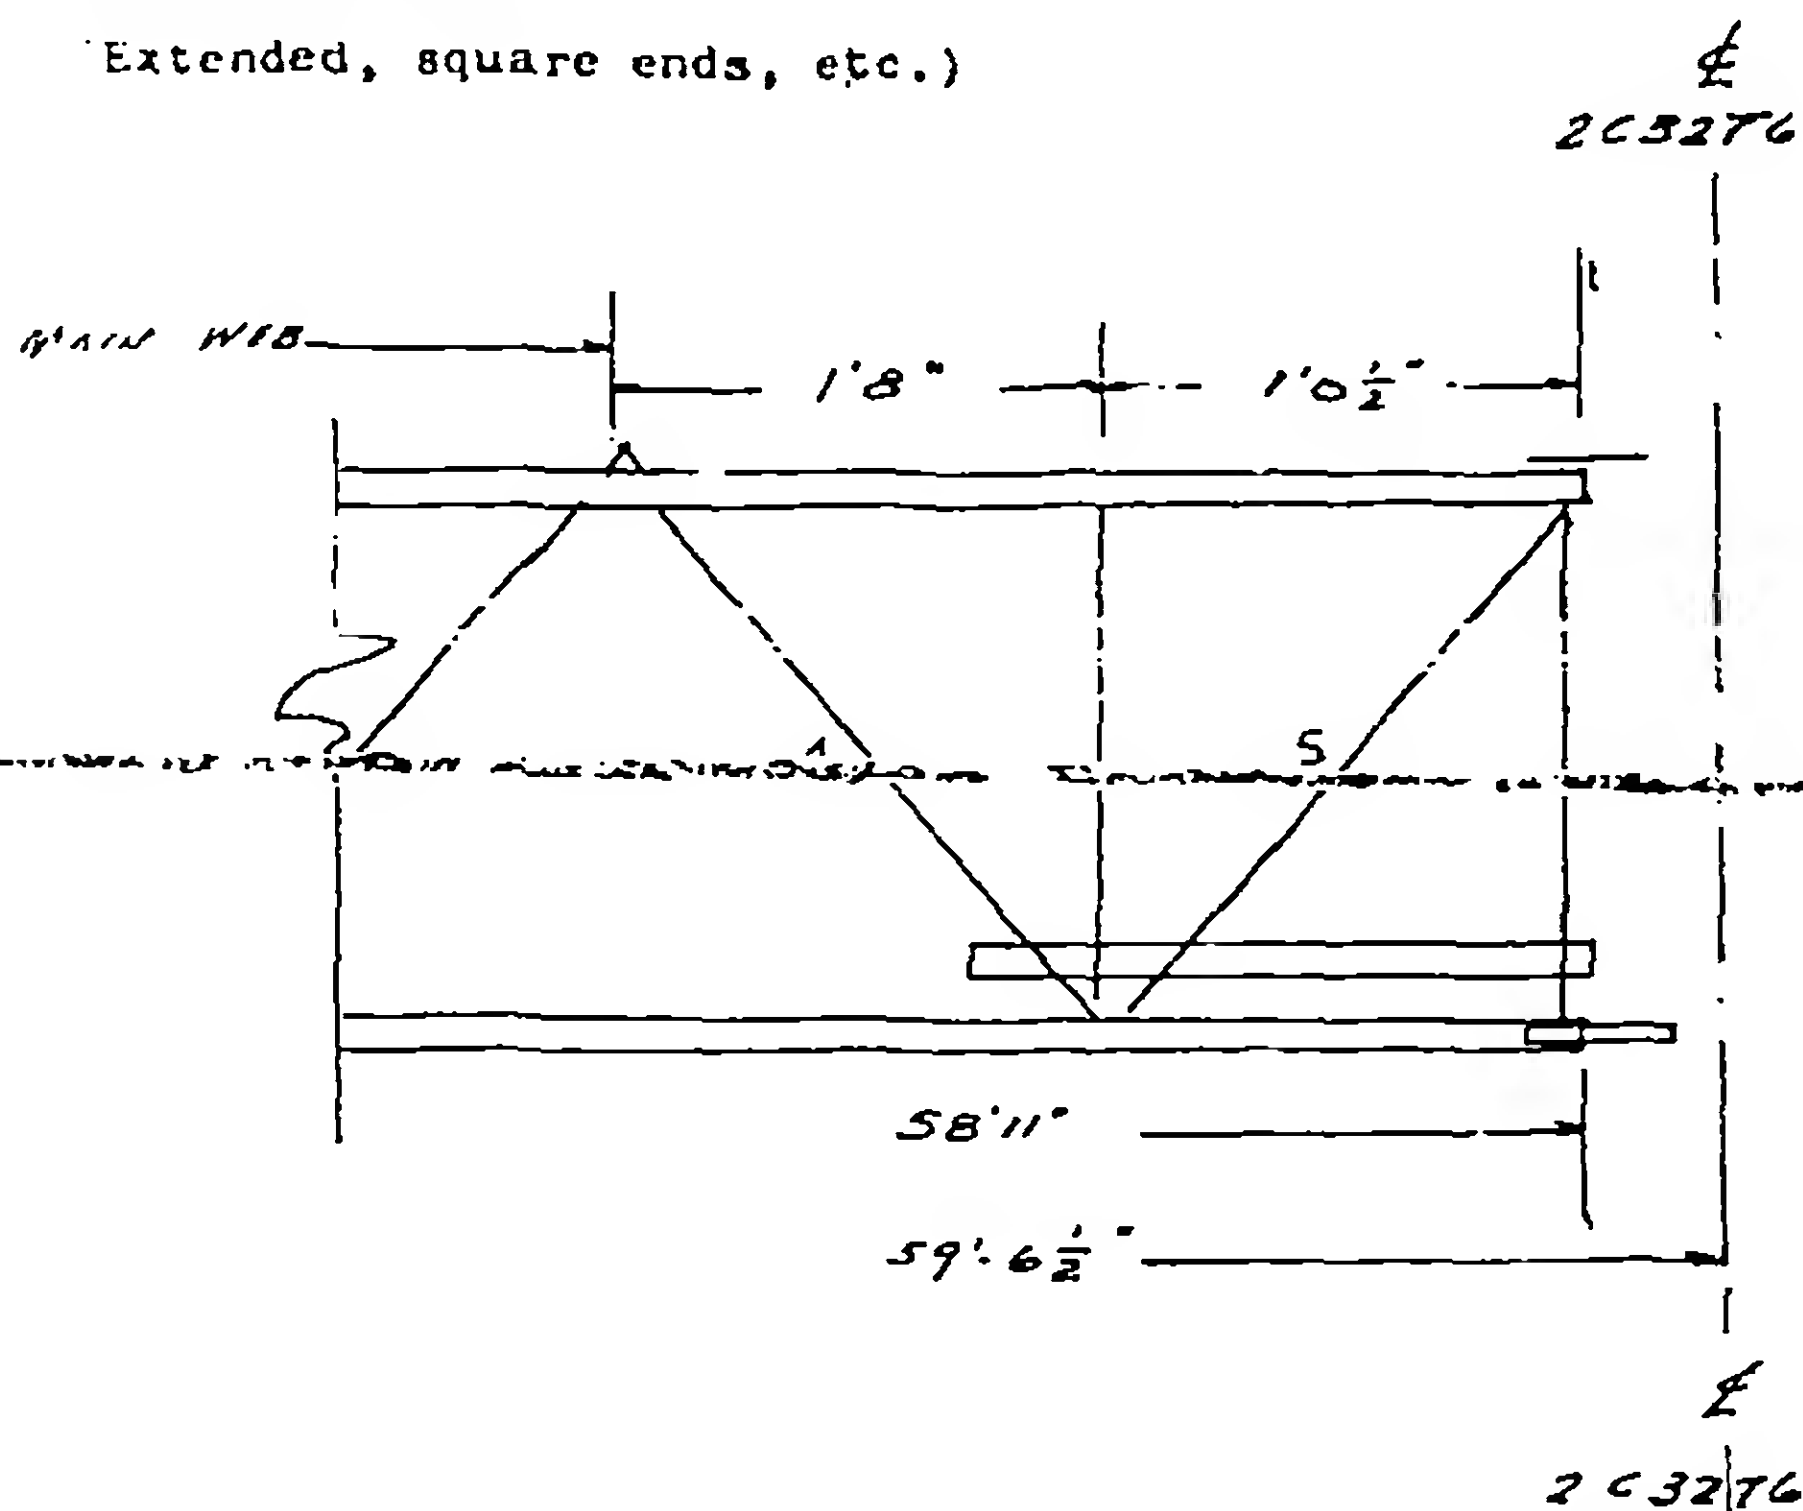

WORLD TRADE CENTER
FLOOR GRID TRUSSES
DESIGN DATATRUSS UNIT MARKED 2C32T3A Refer to drawings ST 101, 2, 4, 6, 7.Clearspan "L" = 59.08 ft. Spacing = 6.67 ft.Applicable Total Moment = 1,855,000 inch pounds.Based on lbs./sq. ft. Total Load "w".Applicable End Reaction = 14,000 pounds.Based on 71 lbs./sq. ft. Total Load "w".~~Applicable Total Moment = 1,815,000 inch pounds.~~Based on 52 lbs./sq. ft. Construction Load.Applicable Constr. End Reaction = 10,300 pounds.Based on 52 lbs./sq. ft. Construction Load."V" Shear at End Panel = 12,580 pounds. ED = 3.0 ft.WEB MEMBER #1 Distance from End Panel = 0.0 ft.Applicable Shear V_x = 12,580 lbs. f_y = 50,000 psiSlope = 2.65 f_s = 30,000 psi l = in. f_{sc} = psiReqd. Area = 1.11 sq. in. Use 2-0.92" DIA. Area = 1.33 sq. in.WEB MEMBER #2 Distance from End Panel = 0.0 ft.Applicable Shear V_x = 12,580 lbs. f_y = 36,000 psiSlope = 1.00 f_s = psi l = 26.0 in. f_{sc} = 11,200 psiReqd. Area = 1.12 sq. in. Use 2-0.92" DIA. Area = 1.33 sq. in.WEB MEMBER #3 Distance from End Panel = 4.87 ft.Applicable Shear V_x = 10,270 lbs. f_y = 36,000 psiSlope = 1.162 f_s = psi l = 30.0 in. f_{sc} = 8,750 psiReqd. Area = 1.36 sq. in. Use 2-0.92" DIA. Area = 1.33 sq. in.

WEB MEMBER #4 Distance from End Panel = 250 ft.
 Applicable Shear $V_x = \underline{12,820}$ lbs. $f_y = \underline{50,000}$ psi
 Slope = 1.162 $f_s = \underline{\quad}$ psi
 $l = \underline{30.0}$ in. $f_{sc} = \underline{9,970}$ psi
 Req'd. Area = 1.50 sq. in. Use 2-0.98" D. Area = 1.51 sq. in.

WEB MEMBER #5 Distance from End Panel = 1.17 ft. $E0 = 0$
 Applicable Shear $V_x = \underline{13,450}$ lbs. $f_y = \underline{50,000}$ psi
 Slope = 1.04 $f_s = \underline{30,000}$ psi
 $l = \underline{\quad}$ in. $f_{sc} = \underline{\quad}$ psi
 Req'd. Area = 0.447 sq. in. Use 2-0.98" D. Area = 1.51 sq. in.

CHORD MEMBER #6 Consists of 4 L 2 x 1 1/2 x .25" Angles
 Construction Load Design Area = 3.60 sq. in.
 Applicable Moment = 1,215,000 in. lbs. $f_y = \underline{50,000}$ psi
 $l = \underline{33.375}$ in. $f_s = \underline{\quad}$ psi
 $r_x = \underline{0.44}$ in. $f_{sc} = \underline{19,380}$ psi
 $r_y = \underline{0.31}$ in. (with fillers in middle 60% of span)
 $l_x = \underline{75.8}$
 $l_y = \underline{53.8}$
 $\frac{f_a}{F_a} + \frac{f_b C_m}{F_b (1 - \frac{f_a}{P_e})} = \underline{0.995}$ less than 1
 $f_a = \underline{18,000}$ psi
 $F_a = \underline{19,380}$ psi
 $f_b = \underline{843}$ psi
 $F_b = \underline{30,000}$ psi
 $P_e = \underline{25,950}$ psi

Use 4 L 2 x 1 1/2 x .25" Area = 3.60 sq. in.

CHORD MEMBER #7 Consists of 4 L 2 x 1 1/2 x .25" Angles
 Total Load Design Area = 3.60 sq. in.

CHORD MEMBER #7 (CONTD.)

Applicable Moment = 1,855,000 in lbs. $f_y = \underline{50,000}$ psi $f_s = \underline{30,000}$ psi $f_{sc} = \underline{\quad}$ psi $D_t = \underline{33.00}$ in. $B_{eff} = \underline{64.00}$ in. $t = \underline{4.00}$ in. $y_1 = \underline{2.00}$ in. $d_2 = \underline{2.46}$ in. $y_2 = \underline{4.44}$ in. $d_3 = \underline{25.66}$ in. $y_3 = \underline{32.56}$ in. $c_1 = \underline{6.90}$ in. $u_1 = \underline{4.70}$ in. $c_2 = \underline{26.10}$ in.

$$I_s = \sum [(I_c + A_c d_1^2) + (I_{TCA} + A_{TCA} d_2^2) + I_{BCA} + A_{BCA} d_3^2]$$

$$\bar{y} = \frac{\sum (A_c y_1 + A_{TCA} y_2 + A_{BCA} y_3)}{\sum (A_c + A_{TCA} + A_{BCA})}$$

 $\bar{y} = \underline{6.90}$ in. $I_s = \underline{2,826}$ in.⁴ (2C32T3A)Resisting Moment = $f_s \times \frac{I_s}{c} = \underline{2,300,000}$ in. lbs.Use 4-2" x 1 1/2" x 0.25" L's Area = 3.60 sq. in.

Composite Design Top Chord Check

Total Load Design

 $f_c = \underline{3,000}$ psiApplicable Moment = 1,855,000 in. lbs. $f'_c = \underline{1,350}$ psi


$$f'_{cc} = \frac{M c_1}{15 I_s} = \underline{302}$$
 psi

CHORD MEMBER #8

Consists of 4-2" x 1 1/2" x 0.25" AnglesArea = 3.60 sq. in.

(SAME AS MEMBER 6)

WORLD TRADE CENTER
FLOOR GRID TRUSSES
DESIGN DATA

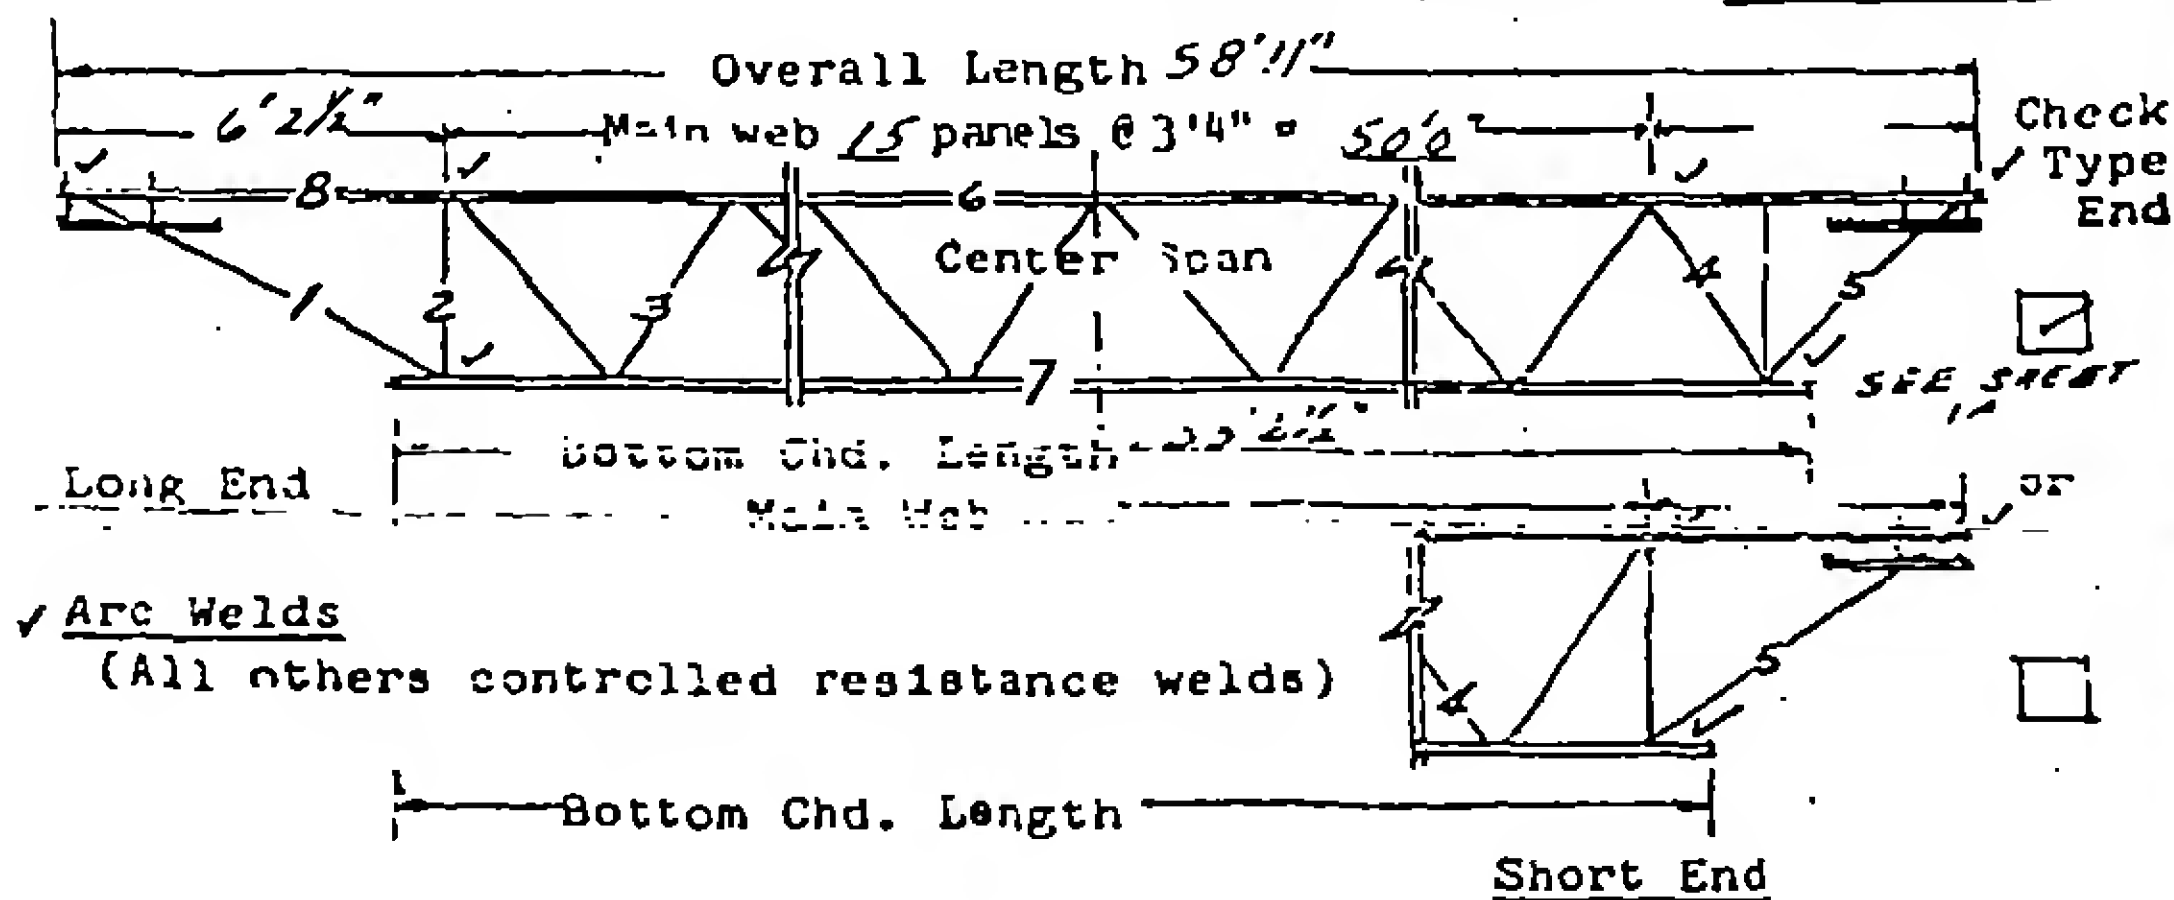Truss Mk. C 32 T 4-5811Truss Component Mk. C 32 T 4

NOTES:

Main Web - Continuous uniform section throughout Member Mk. 3.
(Top chord fillers same section as Main Web - at midpoint center web panels minimum.)

Vertical End Struts - Same size as main web.

End Bearing Struts - Same size as main web.


Composite Type - Webs extend above top chord 3".

MEMBERS REQUIRED PER TRUSS COMPONENT S or C ✓

Member	Mk. No.	Grade of Steel	Size	Total Length Member	Weight Member
Top Chord	6-8	A-441	2 L 2" x 1 1/2" x .25"	58'11"	
Bottom Chord	7	A-36	2 L 2" x 1 1/2" x .25"	53'2 1/2"	
Main Web	3	A-441	.98"D	91'6"	
Compression Web	4	A-441	.98"D	3'1"	
Vertical End Struts	2	A-36	.98"D	2-2'1/2" 2-2'3 1/2"	
Long End Diagonal	1	A-441	.92"D	6'6"	
Short End Diagonal	5	A-36	.92"D	3'6"	
Top Chord Att. Plate		A-36	3/8" x 5"	4 1/2'	
Bottom Chord Att. L		A-36	2 L 2" x 1 1/2" x .25"	6"	

SPECIAL SECTIONS

(Extended, square ends, etc.)

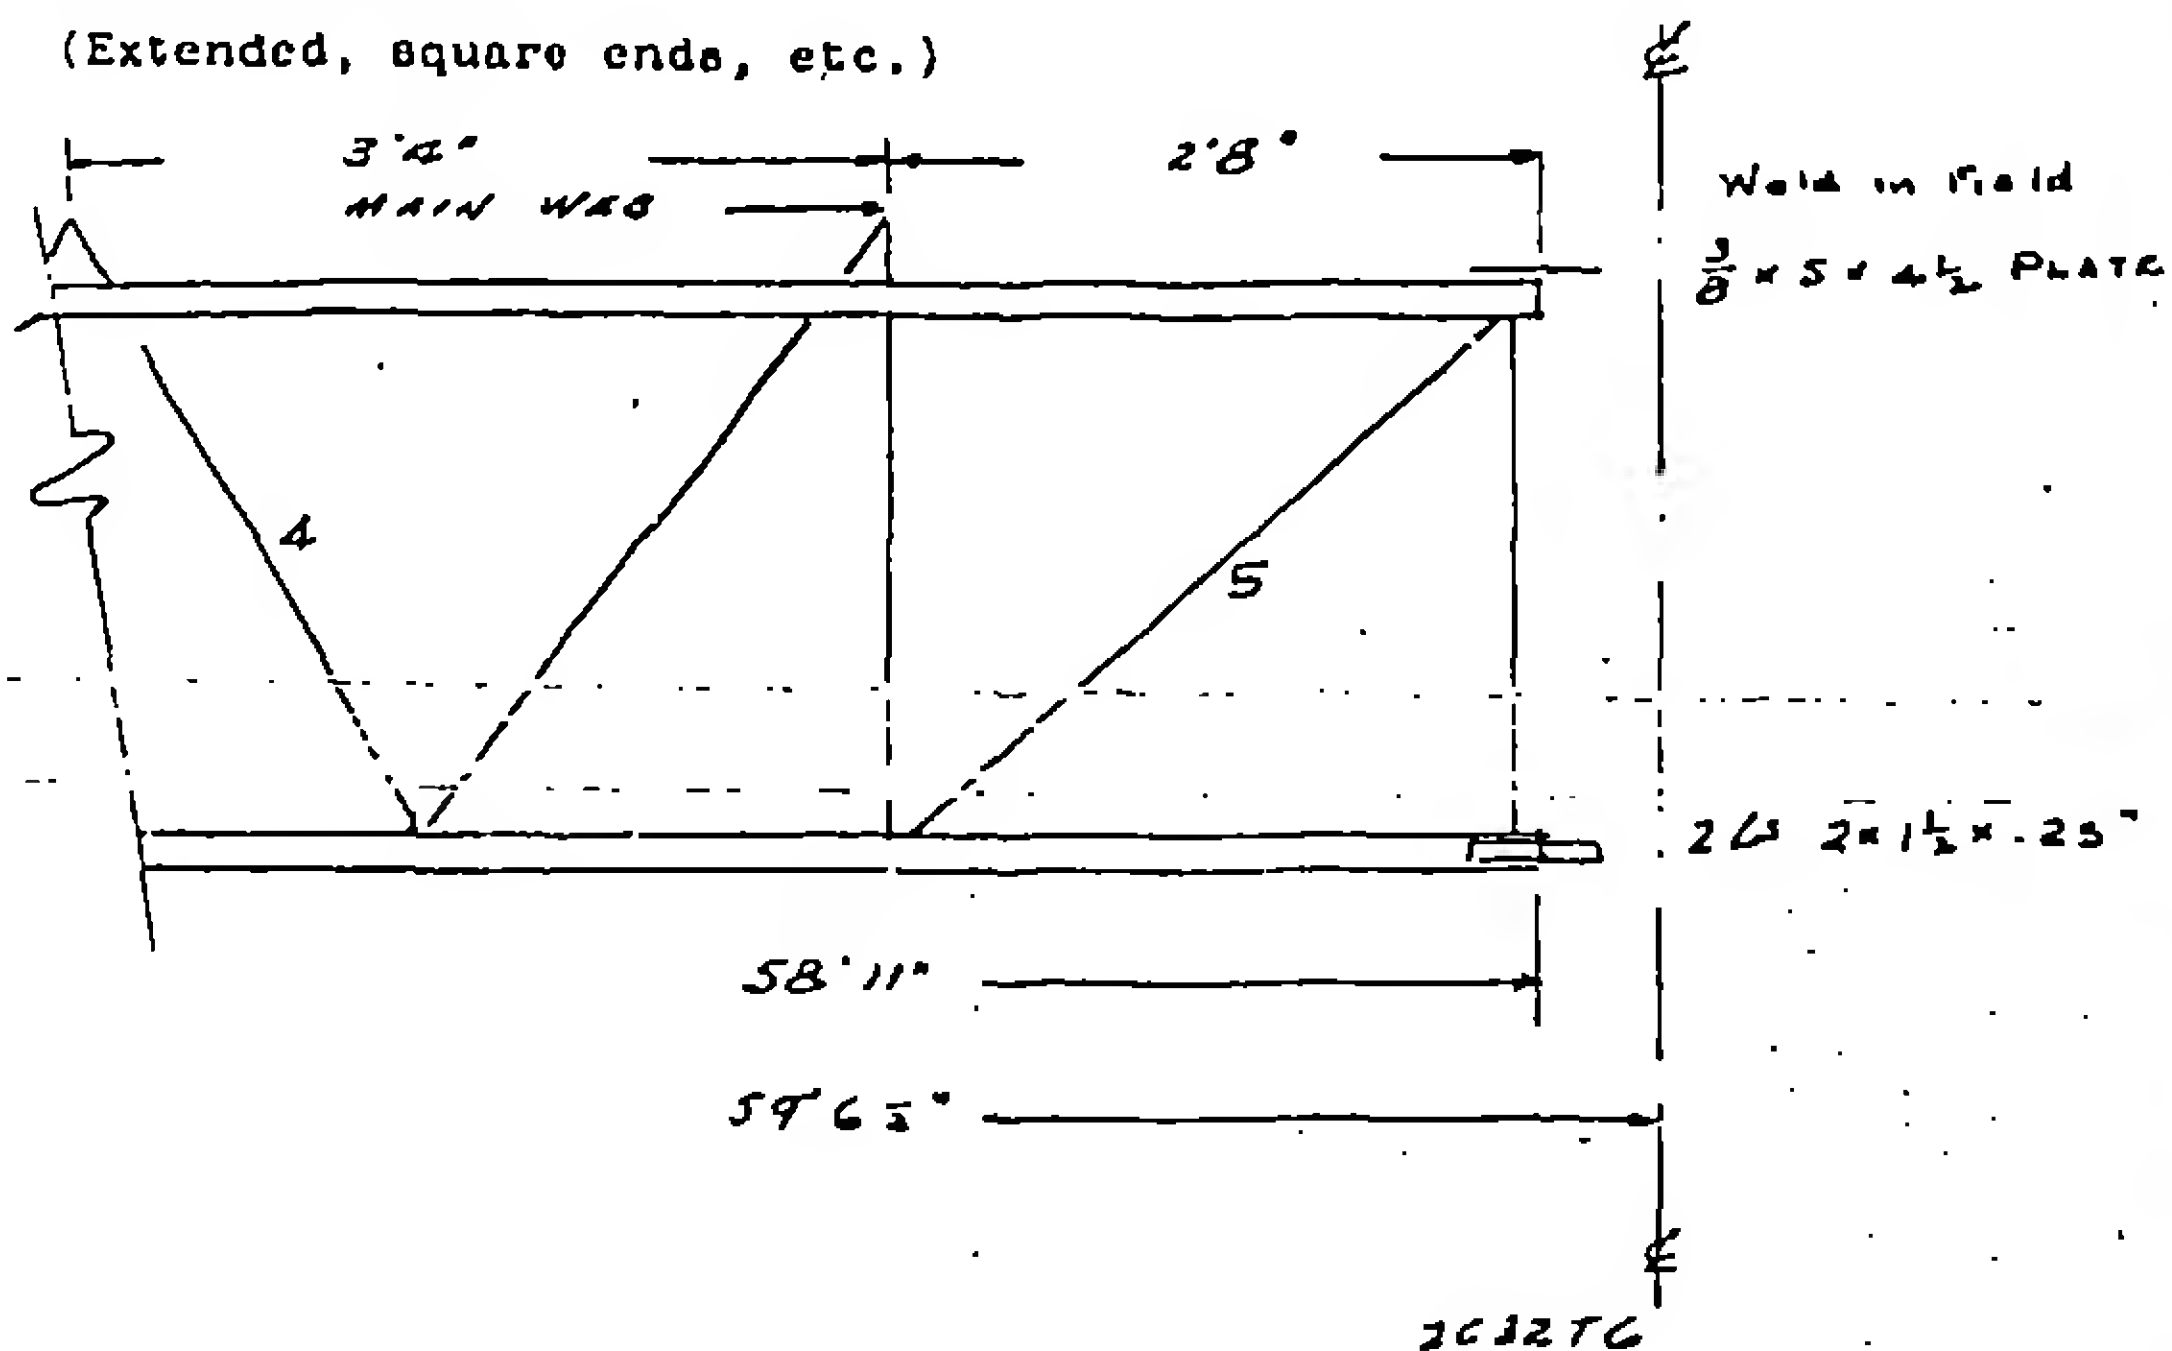

$$P = 8.00 K$$

$$V_5 = \frac{P}{12} = \frac{8.00}{12} = .667 K$$

$$V_4 = V_5 = \frac{36}{12} (.272) = 6.529 K$$

WORLD TRADE CENTER
FLOOR GRID TRUSSES
DESIGN DATA

TRUSS UNIT MARKED C3274 Refer to drawings ST 101.2.4.6.7

Clearspan "L" = 59.08 ft. Spacing = 6.67 ft.

Applicable Total Moment = 500,000 inch pounds.

Based on — lbs./sq. ft. Total Load "W".

Applicable End Reaction = 8000 pounds.

Based on — lbs./sq. ft. Total Load "W".

Applicable Total Constr. Moment = — inch pounds.

Based on — lbs./sq. ft. Construction Load.

Applicable Constr. End Reaction = — pounds.

Based on — lbs./sq. ft. Construction Load.

"V" Shear at End Panel = 7,184 pounds. ED = 3.0 ft.

WEB MEMBER #1 Distance from End Panel = 0.0 ft.

Applicable Shear V_x = 7,184 lbs. f_y = 50,000 psi

Slope = 2.65 f_s = 30,000 psi

f = — f_{sc} = — psi

Reqd. Area = .655 sq. in. Use .725 Area = .667 sq. in.

WEB MEMBER #2 Distance from End Panel = 0.0 ft.

Applicable Shear V_x = 7,184 lbs. f_y = 30,000 psi

Slope = 1.00 f_s = — psi

l = 26.0 in. f_{sc} = 11,200 psi

Reqd. Area = .64 sq. in. Use .925 Area = .667 sq. in.

WEB MEMBER #3 Distance from End Panel = 4.87 ft.

Applicable Shear V_x = 5,800 lbs. f_y = 50,000 psi

Slope = 1.162 f_s = — psi

l = 30.0 in. f_{sc} = 9,970 psi

Reqd. Area = .683 sq. in. Use .985 Area = .755 sq. in.

WEB MEMBER #4 Distance from End Panel = 5.00 ft. EDC 0Applicable Shear $V_x = \underline{6,527}$ lbs. $f_y = \underline{50,000}$ psiSlope = 1.162 $f_s = \underline{\hspace{2cm}}$ psi $l = \underline{300}$ in. $f_{sc} = \underline{7,970}$ psiReqd. Area = .762 sq. in. Use .98"3 Area = .755 sq. in.WEB MEMBER #5 Distance from End Panel = 2.00 ft.Applicable Shear $V_x = \underline{7,456}$ lbs. $f_y = \underline{36,000}$ psiSlope = 1.50 $f_s = \underline{22,000}$ psi $l = \underline{\hspace{2cm}}$ in. $f_{sc} = \underline{\hspace{2cm}}$ psiReqd. Area = .509 sq. in. Use .92"4 Area = .667 sq. in.CHORD MEMBER #6 Consists of 2 Ls 2 x 1 1/2 x .25" AnglesConstruction Load Design Area = 1.80 sq. in.Applicable Moment = in. lbs. $f_y = \underline{\hspace{2cm}}$ psi $l = \underline{\hspace{2cm}}$ in. $f_s = \underline{\hspace{2cm}}$ psi $r_x = \underline{\hspace{2cm}}$ in. $f_{sc} = \underline{\hspace{2cm}}$ psi $r_z = \underline{\hspace{2cm}}$ in. (with fillers in middle 60% of span) $\frac{l}{r_x} = \underline{\hspace{2cm}}$ $\frac{l}{2r_z} = \underline{\hspace{2cm}}$ $\frac{f_a}{F_a} + \frac{f_b C_m}{F_b (1 - \frac{f_a}{F_e})} = \underline{\hspace{2cm}}$ less than 1 $f_a = \underline{\hspace{2cm}}$ psi $F_a = \underline{\hspace{2cm}}$ psi $f_b = \underline{\hspace{2cm}}$ psi $F_b = \underline{\hspace{2cm}}$ psi $F_e = \underline{\hspace{2cm}}$ psiUse Area = sq. in.CHORD MEMBER #7 Consists of 2 Ls 2 x 1 1/2 x .25" AnglesTotal Load Design Area = 1.80 sq. in.

CHORD MEMBER #7 (CONTD.)

Applicable Moment = 500,000 in lbs. $f_y = \underline{36000}$ psi

$D_t = \underline{33.375}$ in.

$f_s = \underline{22000}$ psi

$B_{eff} = \underline{64.0}$ in.

$f_{sc} = \underline{\hspace{1cm}}$ psi

$t = \underline{4.0}$ in.

$y_1 = \underline{2.0}$ in.

$d_2 = \underline{.43}$ in.

$y_2 = \underline{4.44}$ in.

$d_3 = \underline{27.69}$ in.

$y_3 = \underline{32.56}$ in.

$c_1 = \underline{4.87}$ in.

$d_1 = \underline{2.87}$ in.

$c_2 = \underline{28.13}$ in.

$$I_s = \sum [(I_c + A_c d_1^2) + (I_{TCA} + A_{TCA} d_2^2) + I_{BCA} + A_{BCA} d_3^2]$$

$$\bar{y} = \frac{\sum (A_c y_1 + A_{TCA} y_2 + A_{BCA} y_3)}{\sum (A_c + A_{TCA} + A_{BCA})}$$

$\bar{y} = \underline{4.87}$ in.

$I_s = \underline{1540}$ in.⁴ (C3274)

Resisting Moment = $f_s \times \frac{I_s}{c_2} = \underline{1,205,000}$ in. lbs.

Use 2Ls 2x1 1/2 x .75 Area = 1.80 sq. in.

Composite Design Top Chord Check

Total Load Design

$f_c = \underline{3000}$ psi

Applicable Moment = 500,000 in. lbs.

$f'_c = \underline{1,350}$ psi

$$f'_{cc} = \frac{M_c}{15 I_s} = \underline{105}$$
 psi

CHORD MEMBER #8

Consists of 2Ls 2x1 1/2 x .75 Angles


Area = 1.80 sq. in.

(SAME AS MEMBER 6)

LACLEDE STEEL COMPANY

D105- 5 - Sheet 1

WORLD TRADE CENTER
FLOOR GRID TRUSSES
DESIGN DATA

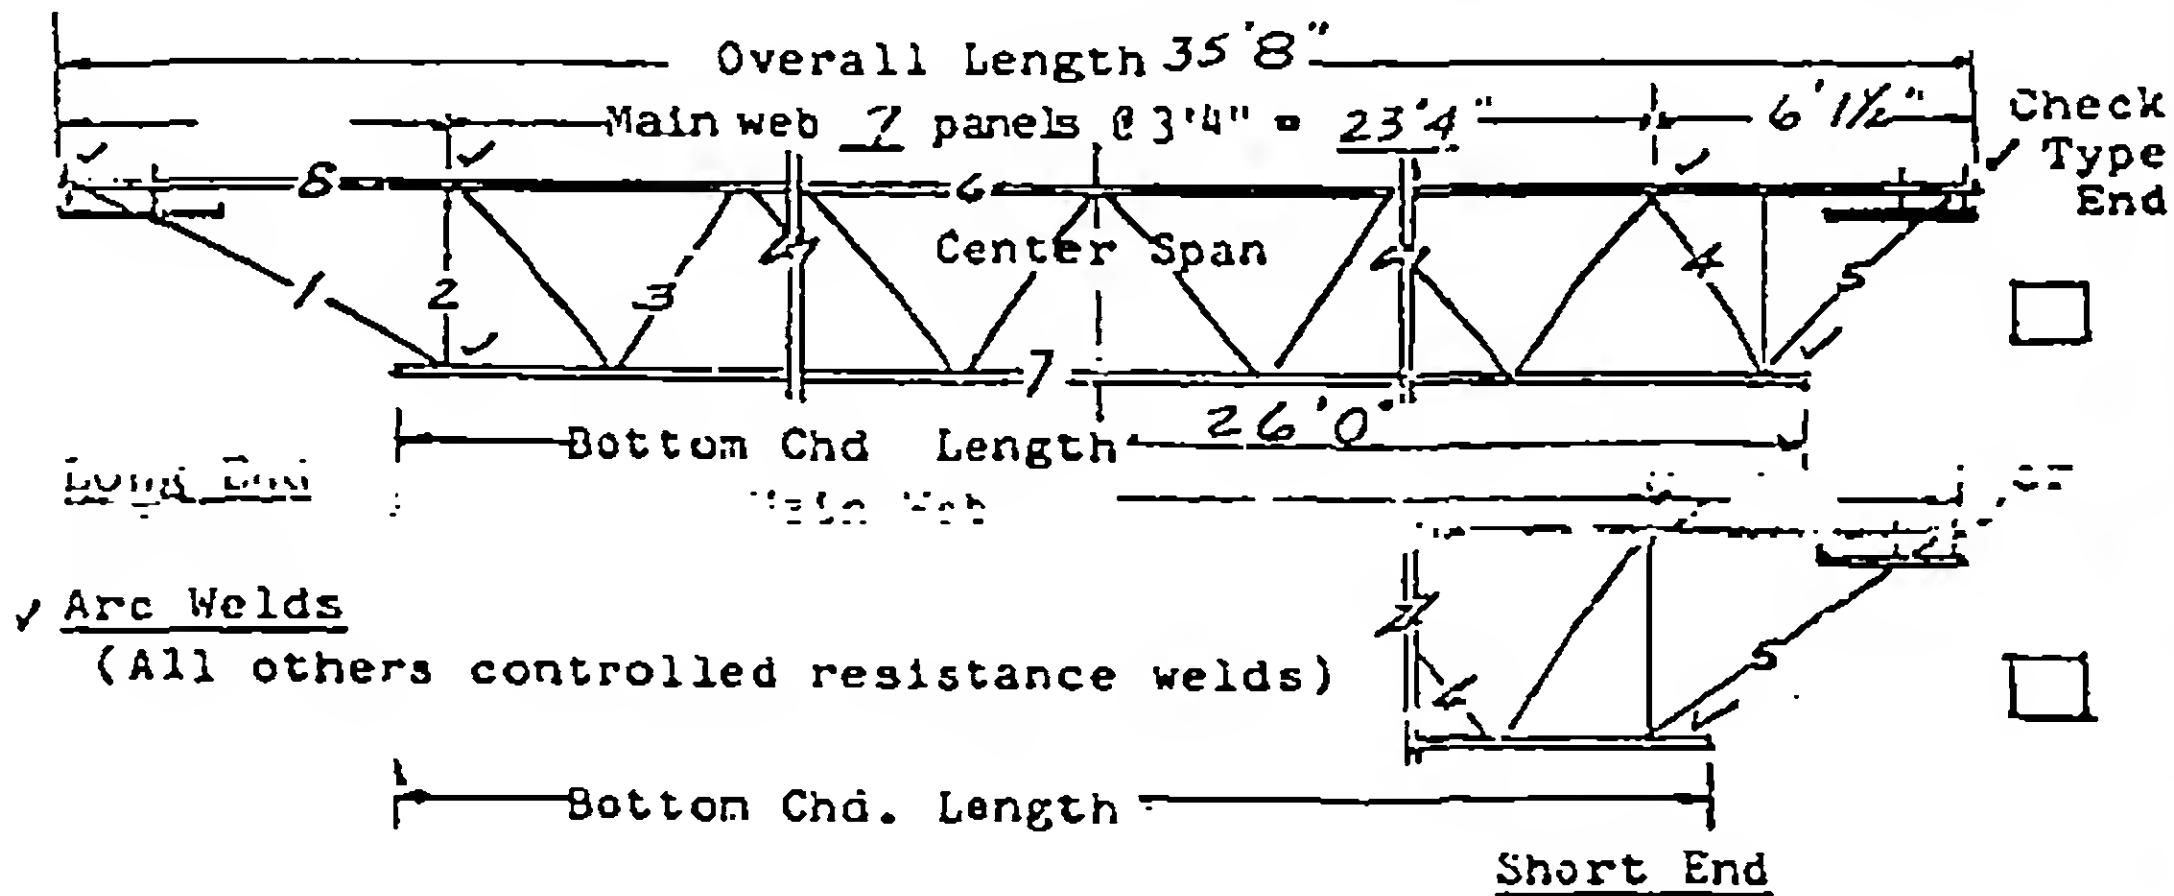Truss Mk. 2C32T5-358Truss Component Mk. C32T5-358

NOTES:

Main Web - Continuous uniform section throughout Member Mk. 3.
(Top chord fillers same section as Main Web - at midpoint NONE
center web panels minimum.)

Vertical Struts Mk. 2 - Same size as main web.

End Bearing Struts - Same size as main web.

Composite Type - Webs extend above top chord 3".

MEMBERS REQUIRED PER TRUSS COMPONENT S or C ✓

Member	Mk. No.	Grade of Steel	Size	Total Length Member	Weight Member
Top Chord	6-8	A-441	2-2" x 1/2" x 0.25"		
Bottom Chord	7	A-36	2-2" x 1/2" x 0.25"		
Main Web	3	A-36	0.92" DIA.		
Compression Web	4	A-441	0.98" DIA.		
Vertical End Struts	2	A-36	0.92" DIA.		
Long End Diagonal	1	A-441	0.92" DIA.		
Short End Diagonal	5	A-441	0.92" DIA.		

SPECIAL SECTIONS

(Extended, square ends, etc.)